

STATE OF KANSAS
STATE CORPORATION COMMISSION

WELL PLUGGING RECORD


~~INFORMATION PLUGGING RECORD~~

Give All Information Completely
Make Required Affidavit
Mail or Deliver Report to:
Conservation Division
State Corporation Commission
800 Bittling Building
Wichita, Kansas

OR

Strike out upper line
when reporting plug-
ging off formations.

NORTH

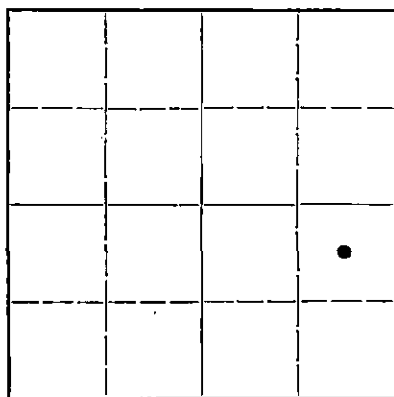

Locate well correctly on above
Section Plot

Reno County. Sec. 26 Twp. 23 Rge. (E) 4 (W) 4
Location as "NE $\frac{1}{4}$ NW $\frac{1}{4}$ SW $\frac{1}{4}$ " or footage from lines 660' fm Nth & East SE/4
Lease Owner Sinclair Prairie Oil Co
Lease Name Adam T. Base Well No. 4
Office Address Box 521 Tulsa, Okla.
Character of Well (completed as Oil, Gas or Dry Hole) Oilwell
Date well completed May 9 19 34
Application for plugging filed May 21 19 47
Application for plugging approved May 26 19 47
Plugging commenced May 17 19 47
Plugging completed May 24 19 47
Reason for abandonment of well or producing formation Production depleted

If a producing well is abandoned, date of last production Feb. 19 47
Was permission obtained from the Conservation Division or its agents before plugging was com-
menced? YES

Name of Conservation Agent who supervised plugging of this well Ruel Durkee
Producing formation Chat Depth to top 3249 Bottom Total Depth of Well 3374 Feet
Show depth and thickness of all water, oil and gas formations.


OIL, GAS OR WATER RECORDS

CASING RECORD

Formation	Content	From	To	Size	Put In	Pulled Out
Chat	dry	3249	3374	15 $\frac{1}{2}$ "	240	0
				12 $\frac{1}{2}$ "	490	
				8 $\frac{1}{2}$ "	3261	2357'

Describe in detail the manner in which the well was plugged, indicating where the mud fluid was placed and the method or methods used in introducing it into the hole. If cement or other plugs were used, state the character of same and depth placed, from _____ feet to _____ feet for each plug set.

3374-3261' mud
3261-3230' cement 8sx
3230-350' mud
350-325' cement 25 sx
325-15' mud
15' to base cellar, cement 10 sx

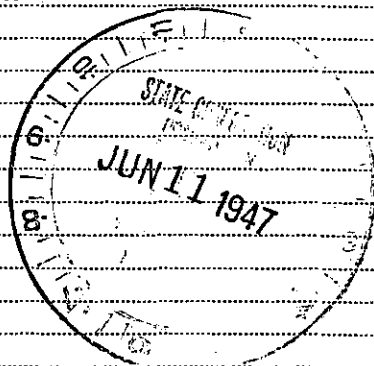

(If additional description is necessary, use BACK of this sheet)

Correspondence regarding this well should be addressed to Mr E.H. Gibbons
Address Bx 774 Great Bend, Kans

STATE OF Kansas, COUNTY OF Barton, ss.
I., E.H. Gibbons (employee of owner) or (owner or operator) of the above-described well,
being first duly sworn on oath, says: That I have knowledge of the facts, statements, and matters herein contained and the log of the above-
described well as filed and that the same are true and correct. So help me God.

(Signature) *E.H. Gibbons*
Bx 774 Great Bend, Kas (Address)

SUBSCRIBED AND SWORN to before me this 10th day of June, 19 47
W. MacFarlane Notary Public.

My commission expires 6-14-47

PLUGGING
FILE SEC 26 T 23 R 4W
BOOK PAGE 111 LINE 9

Well Log
Sinclair Prairie Oil Co.
Adam T. Base - Well #4
SE/4 Sec. 26-23S-4W,
Reno County, Kansas.

15-155-02671-0000

Started: 4-4-34
Completed 5-7-34

Sand & Shale	0 to 125
Shale & Shells	961
Lime	976
Shale & Shells	1245
Lime & Shale	1412
Shale & Shells	1702
Lime Shells & Shale	1812
Shale	2379
Shale & Lime	2525
Lime	2693
Lime & Shale	2730
Lime	2806
Lime & Shale	2838
Lime	2894
Lime & Shale	2984
Lime	3010
Lime & Shale	3178
Hard Lime	3186
Shale	3228
Shale, Lime & Chat	3249
Chat & Lime	3261
Chat	3338
Chat & Hard Lime	3349
Lime & Chat	3374

15 $\frac{1}{4}$ " Casing set @	240'
12 $\frac{1}{8}$ " Casing set @	490
8 $\frac{1}{4}$ " Pipe Set at	3261'

PLUGGING
FILE SEC. 26 T. 23 R. 4W
BOOK PAGE 111 LINE 9