

STATE OF KANSAS
STATE CORPORATION COMMISSION


WELL PLUGGING RECORD

Give All Information Completely
Make Required Affidavit
Mail or Deliver Report to:
Conservation Division
State Corporation Commission
800 Biting Building
Wichita, Kansas

OR
~~XXX INFORMATION PLUGGING RECORD XXX~~

Strike out upper line
when reporting plug-
ging off formations.

NORTH

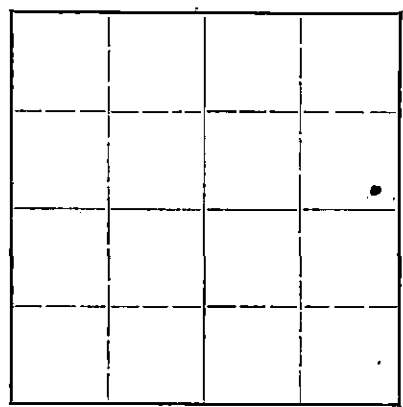

Locate well correctly on above
Section Plat

Stafford County. Sec. 14 Twp. 24 Rge. (E) 11 (W)
Location as "NE 1/4 NW 1/4 SW 1/4" or footage from lines NE 1/4, 330' fm Sth & East lines

Lease Owner Sinclair Prairie Oil Co

Lease Name John Krey Well No. 4

Office Address Box 521, Tulsa, Okla.

Character of Well (completed as Oil, Gas or Dry Hole) Oilwell

Date well completed Oct 26 1936

Application for plugging filed June 22 1948

Application for plugging approved June 24 1948

Plugging commenced Sept 6 1948

Plugging completed Sept 9 1948

Reason for abandonment of well or producing formation Production depleted

If a producing well is abandoned, date of last production June 1948

Was permission obtained from the Conservation Division or its agents before plugging was com-
menced? yes

Name of Conservation Agent who supervised plugging of this well C.D. Stough

Producing formation Viola Depth to top 3792 Bottom 3794 Total Depth of Well 3794 Feet

Show depth and thickness of all water, oil and gas formations.

OIL, GAS OR WATER RECORDS


CASING RECORD

Formation	Content	From	To	Size	Put In	Pulled Out
Misener Sand	dry	3774	3792	13"	261'	none
Viola Lime	"	3792	3794	7"	3774'	2970'

Describe in detail the manner in which the well was plugged, indicating where the mud fluid was placed and the method or methods used in introducing it into the hold. If cement or other plugs were used, state the character of same and depth placed, from _____ feet to _____ feet for each plug set.

- 3794-3750' rock
- 3750-3720' cement 6 sx
- 3720- 250 mud
- 250- 225' cement 20 sx
- 225- 10' mud
- 10' to cellar cement 10 sx

9-21-1948

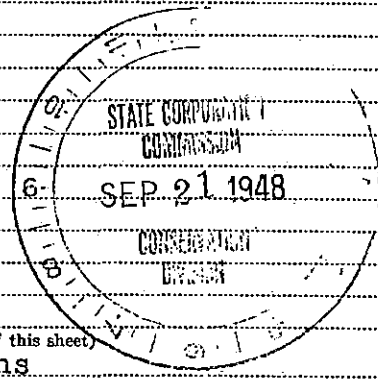

(If additional description is necessary, use BACK of this sheet)

Correspondence regarding this well should be addressed to Mr E.H. Gibbons
Address Box 774, Great Bend, Kas

STATE OF Kansas, COUNTY OF Barton, ss.
E.H. Gibbons (employee of owner) or ~~owner or operator~~ of the above-described well,

being first duly sworn on oath, says: That I have knowledge of the facts, statements, and matters herein contained and the log of the above-described well as filed and that the same are true and correct. So help me God.

(Signature) [Handwritten Signature]

Box 774 Great Bend, Kas
(Address)

SUBSCRIBED AND SWORN to before me this 20 day of September, 1948
Martha M. Geil.

My commission expires Sept-19, 1950

Notary Public.

21-6858-RS 2-47-GM

PLUGGING
FILE SEC 14T24R11W
BOOK PAGE 39 LINE 39

Sinclair Prairie Oil Co.
Well Log
John Krey #4

15-185-10310-0000

Sec. 14-24S-11W
Stafford Co. Kansas.
NE/4 330' from So. & East Lines
Elev. 1806

Drilling Began 10-3-38
Completed 10-26-38
Drilled to TD 3794
Orig. Potential 1532 bbls oil

Clay	30'	
Sand & Shale	290	
Shale & Shells	1260	
Salt & Shale	1315	
Shale & Lime	1495	
Broken Lime	1615	
Lime	1845	
Broken Lime	1885	
Lime	1940	
Broken lime, shale & shells	2240'	
Shale & Shells	2435	
Shale & Lime Shells	2635	
Broken Lime & Lime Shells	2790	
Lime, shale & shells	2855	
Shale, Lime & Shells	2950	
Lime	3025	
Shale	3035	
Lime	3245	
Shale & Lime Shells	3260	
Shale & Shells	3338	
Lime	3385	
Shale & Lime Shells	3410	Top of KC Lime
KC Lime	3475	
Broken Lime & Chert	3510	
Lime	3595	
Shale & Lime	3765	
Shale	3780	
Sand	3784	Top of Misener Sand 3774'
Sand	3792	
Lime	3794	TD

JUN 24 1939

