


STATE OF KANSAS
STATE CORPORATION COMMISSION

WELL PLUGGING RECORD

Give All Information Completely
Make Required Affidavit
Mail or Deliver Report to:
Conservation Division
State Corporation Commission
211 No. Broadway
Wichita, Kansas

Stafford County. Sec. 14 Twp. 24S Rge. 11W (E) (W)
Location as "NE/CNW&SW" or footage from lines G/ SW SE NE
Lease Owner Sinclair Oil & Gas Company
Lease Name John Krey Well No. 8
Office Address P.O. Box 521, Tulsa, Oklahoma
Character of Well (completed as Oil, Gas or Dry Hole) Depleted Oil Well
Date well completed 12-21 1938
Application for plugging filed 4-22 1957
Application for plugging approved 4-23 1957
Plugging commenced 7-17 1957
Plugging completed 7-20 1957
Reason for abandonment of well or producing formation Oil depleted. No other possible producing formation.
If a producing well is abandoned, date of last production March 1957
Was permission obtained from the Conservation Division or its agents before plugging was commenced? Yes

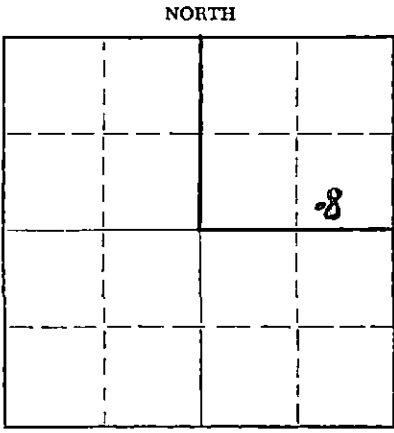

Locate well correctly on above Section Plat

Name of Conservation Agent who supervised plugging of this well Milton Galyardt
Producing formation Viola Lime Depth to top 3803' Bottom 3804' Total Depth of Well 3804' Feet
Show depth and thickness of all water, oil and gas formations.

OIL, GAS OR WATER RECORDS

CASING RECORD

FORMATION	CONTENT	FROM	TO	SIZE	PUT IN	PULLED OUT
Misener Sand	Oil Depleted	3778'	3803'	13"	257'	None
Viola Lime	Oil Depleted	3803'	3804'	7"	3778'	2696'

Describe in detail the manner in which the well was plugged, indicating where the mud fluid was placed and the method or methods used in introducing it into the hole. If cement or other plugs were used, state the character of same and depth placed, from _____ feet to _____ feet for each plug set.

Checked the hole to 3804' and found it open.
Filled with sand to 3760' and ran 6 sacks of cement to 3730'. Pulled 7" casing. Bailed the hole to 255', set a 10' rock bridge and ran 30 sacks of cement. Mudded the hole to 35', set a 10' rock bridge and ran 20 sacks of cement to the base of the cellar.

(If additional description is necessary, use BACK of this sheet)
Name of Plugging Contractor West Supply Co., Inc.
Address Chase, Kansas

STATE OF Kansas, COUNTY OF Rice, SS. _____ (employee of owner) or (~~owner~~) of the above-described well, being first duly sworn on oath, says: That I have knowledge of the facts, statements, and matters herein contained and the log of the above-described well as filed and that the same are true and correct. So help me God.

(Signature) William C. Hess
P. O. Box 551, Chase, Kansas
(Address)

SUBSCRIBED AND SWORN TO before me this 24 day of July, 19 57

My commission expires 21 Oct. 1959
William C. Hess Notary Public.
STATE CORPORATION COMMISSION

PLUGGING
FILE SEC 14 T 24 R 11W
BOOK PAGE 8 LINE 9

7-25-1957
JUL 25 1957
CONSERVATION DIVISION
Wichita, Kansas

WELL LOG
SINCLAIR OIL & GAS COMPANY

John Krey Well #8
 Sec. 14-24S-11W, Stafford, County, Kansas
 330' from South Line. and 990' from East Line of the NE/4
 Elevation: 1811 G.L.
 Harbar Drilling Company - Rotary Tools.
 Began Drilling: December 2, 1938
 Drilling Completed: December 21, 1938
 Commenced Producing: Jan. 17, 1939.
 Total Depth: 3804' in Viola.

DRILLERS LOG

Sand	131	Broken Lime	2675
Shale	244	Lime	2740
Rock & Shale	280	Shale & Lime Shells	2795
Shale & Shells	1045	Lime	2850
Salt & Shale	1380	Shale & Shells	2885
Shale & Lime Shells	1580	Lime	3260
Lime	1810	Shale & Lime Shells	3295
Broken Lime	1850	Lime	3315
Shale & Shells	1890	Shale & Shells	3348
Lime	1915	Shale	3388
Shale	1920	Lime	3499
Shale & Shells	1930	Green Shale	3506
Lime	2035	Lime	3750
Shale & Shells	2150	Shale & Shells	
Broken Lime & Chert	2185	Top Misener Sand 3778'	3770
Shale & Lime Shells	2195	Shale	
Shale	2305	Top Viola Lime 3803	3783
Shale & Lime Shells	2620	Sand	3804 TD

Acidized Jan. 5, 1939 with 1,000 gallons.
 Acidized Jan. 9, 1939 with 2,000 gallons.
 Acidized December 12, 1953 with 10,000' Sand and 5,000 gal. acid. Prod. before 2 oil & 20 water. After 5 oil and 100 water.
 Well produced from Misener Sand 2778 to 3803' from completion date in 1938 until 3/15/57 when well was shut down producing all water and no oil. Misener depleted.

CASING RECORD

13" OD 15# & 50#.
 7" OD 24# SS

257' set with 275 sx. cement.
 3778' set with 150 sacks cement.

PLUGGING			
FILE	SEC. 14	T. 24	R. 11W
BOOK	PAGE 8	LINE 9	

RECEIVED
 STATE OF KANSAS COMMISSIONER OF
 CONSERVATION

APR 23 1957

Wichita, K