

STATE OF KANSAS
STATE CORPORATION COMMISSION

WELL PLUGGING RECORD


Give All Information Completely
Make Required Affidavit
Mail or Deliver Report to:
Conservation Division
State Corporation Commission
800 Bittling Building
Wichita, Kansas

OR

INFORMATION PLUGGING RECORD

Strike out upper line
when reporting plug-
ging off formations.

NORTH

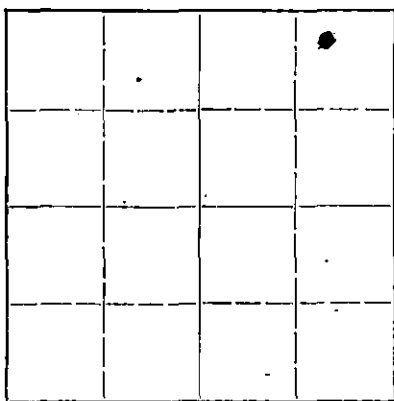

Locate well correctly on above
Section Plat

Stafford County. Sec. 14 Twp. 24S Rge. (E) 11 (W)
Location as "NE $\frac{1}{4}$ NW $\frac{1}{4}$ SW $\frac{1}{4}$ " or footage from lines NE $\frac{1}{4}$, 330' fm Nth, 660' fm East lines
Lease Owner Sinclair Prairie Oil Co
Lease Name John Krey Well No. 10
Office Address Box 521, Tulsa, Okla.
Character of Well (completed as Oil, Gas or Dry Hole) Oil Well
Date well completed June 6 1939
Application for plugging filed June 22 1948
Application for plugging approved June 24 1948
Plugging commenced July 28 1948
Plugging completed July 31 1948
Reason for abandonment of well or producing formation Production depleted

If a producing well is abandoned, date of last production Jan 1946
Was permission obtained from the Conservation Division or its agents before plugging was commenced? yes

Name of Conservation Agent who supervised plugging of this well C.D. Stough
Producing formation KK Viola Lime Depth to top 3772 Bottom Total Depth of Well 3810 Feet
Show depth and thickness of all water, oil and gas formations.


OIL, GAS OR WATER RECORDS

CASING RECORD

Formation	Content	From	To	Size	Put In	Pulled Out
Viola	dry	3772	3810	13" 7"	231' 3749'	0 2966'

Describe in detail the manner in which the well was plugged, indicating where the mud fluid was placed and the method or methods used in introducing it into the hold. If cement or other plugs were used, state the character of same and depth placed, from feet to feet for each plug set.

3810-3749' rock
3749-3715' cmt. 6 sx
3715-231' mud
231-200 cmt. 20 sx
200-15' mud
15 - btm cellar cmt. 10 sx

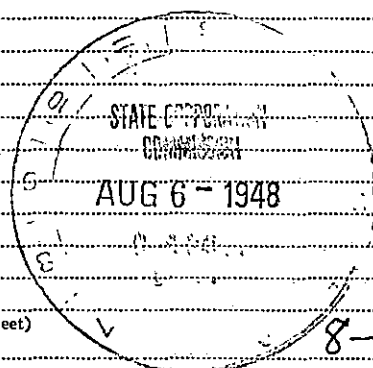

(If additional description is necessary, use BACK of this sheet)

Correspondence regarding this well should be addressed to Mr. E.H. Gibbons
Address Box 774 Great Bend, Kas

STATE OF Kansas, COUNTY OF Barton, ss.

I, E.H. Gibbons (employee of owner) or (owner/proprietor) of the above-described well,
being first duly sworn on oath, says: That I have knowledge of the facts, statements, and matters herein contained and the log of the above-described well as filed and that the same are true and correct. So help me God.

(Signature)


E.H. Gibbons

Bx 774, Great Bend, Kas
(Address)

SUBSCRIBED AND SWORN to before me this 5th day of July, 1948

My commission expires 9/22/51

[Signature]
Notary Public.

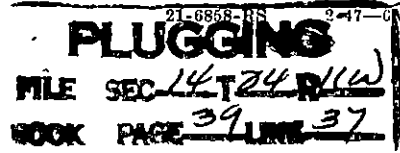

Sinclair Prairie Oil Co.
Well Log
John Krey Lse Well #10

15-185-19288-0001

Sec. 14-24S-11W
Stafford Co. Kansas
330' from North Line) NE/4
660' from East Line)
Elevation 1806

Drilling Began 5-22-39
Completed 6-6-39
Drilled to TD3810
Initial Potential 1182 bbls

Soft Sand	154
Red Bed & Sand	230
Red Bed & Gravel	285
Red Bed & Shells	460
Shale & Shells	980
Salt & Shale	1220
Shale Shells & Salt	1375
Shale & Shells	1506
Lime	1678
Shale & Sand	1708
Lime & Shale	1730
Broken Lime	1980
Shale	2012
Lime	2080
Lime & Shale	2170
Broken Lime	2225
Lime	2355
Broken Lime	2502
Shale & Lime	2552
Lime	2590
Lime & Shale	2770
Sandy Lime	2785
Lime	2810
Shale	2870
Lime	3020
Broken Lime	3090
Lime	3240
Lime & Shale	3300
Shale & Shells	3340
Lime	3380
Lime & Shale	3440
Lime	3465
Cherty Lime	3475
Lime	3615
Lime & Shale	3752
Sandy Shale	3758
Sandy Lime	3759
Sand	3772
Lime	3810 $\frac{1}{2}$

13" Surface Casing 231'
7" Oil String Casing 3749'

