


WELL PLUGGING RECORD

Give All Information Completely
Make Required Affidavit
Mail or Deliver Report to:
Conservation Division
State Corporation Commission
800 Bittling Building
Wichita, Kansas

Stafford County, Sec. 14 Twp. 24S Rge. 11 (E) W (W)
Location as "NE/CNW $\frac{1}{4}$ /SW $\frac{1}{4}$ " or footage from lines CNW $\frac{1}{2}$ NE $\frac{1}{2}$ SE $\frac{1}{2}$
Lease Owner The Pure Oil Company
Lease Name John Krey Well No. 13
Office Address Box 271 - Tulsa, Oklahoma
Character of Well (completed as Oil, Gas or Dry Hole) Oil
Date well completed 1-19 19.39
Application for plugging filed 10-30 19.52
Application for plugging approved 11-1 19.52
Plugging commenced 11-3 19.52
Plugging completed 11-14 19.52
Reason for abandonment of well or producing formation No longer profitable

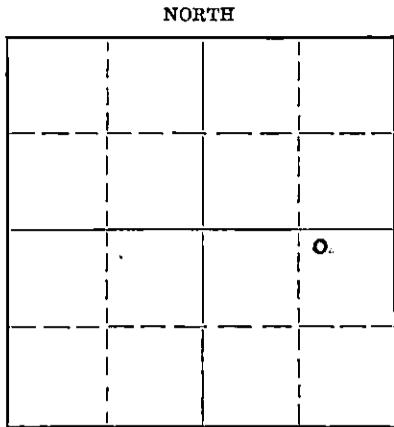

Locate well correctly on above Section Plat

If a producing well is abandoned, date of last production 3-27 19.52
Was permission obtained from the Conservation Division or its agents before plugging was commenced? Yes

Name of Conservation Agent who supervised plugging of this well M. A. Rives
Producing formation Misener Sand Depth to top 3782 $\frac{1}{2}$ Bottom 3795 Total Depth of Well 3802 Feet
Show depth and thickness of all water, oil and gas formations.

OIL, GAS OR WATER RECORDS

CASING RECORD

Formation	Content	From	To	Size	Put In	Pulled Out
Misener		3782 $\frac{1}{2}$	3795	10 $\frac{3}{4}$ " OD	258	
				7" OD	3785	2016
				5" OD	3784	2821

Describe in detail the manner in which the well was plugged, indicating where the mud fluid was placed and the method or methods used in introducing it into the hole. If cement or other plugs were used, state the character of same and depth placed, from _____ feet to _____ feet for each plug set.

Filled with crushed rock 2839' to 2825'. 5 sacks cement 2825' to 2780'. Mudded hole 2780' to 2016'. Crushed rock 2016' to 2000'. 7 sacks cement 2000' to 1959'. Mudded hole 1959' to 250'. Crushed rock 250' to 240'. 25 sacks cement 240' to 191'. Mudded hole 191' to 20'. 10 sacks cement 20' to cellar floor which is 6' below surface. Cellar will be mudded to ground level.

11-19-52

(If additional description is necessary, use BACK of this sheet)

Name of Plugging Contractor Forbes Casing Pulling Company
Address Box 221 - Great Bend, Kansas

STATE OF Oklahoma, COUNTY OF Tulsa, ss.
H. E. Schafer (employee of owner) of the above-described well,

being first duly sworn on oath, says: That I have knowledge of the facts, statements, and matters herein contained and the log of the above-described well as filed and that the same are true and correct. So help me God.

(Signature) *H. E. Schafer*
Box 271, Tulsa, Oklahoma (Address)

SUBSCRIBED AND SWORN TO before me this 17th day of November, 1952

W. H. Brown
Notary Public.

My commission expires September 7, 1954

PLUGGING
FILE SEC 14 T 25 R 1124
BOOK PAGE 56 LINE 18

THE PURE OIL COMPANY

WELL LOG

AND RELATED DATA

LOG			
TOP	BOTTOM	THICKNESS	FORMATION
0	70	70	Sand & red bed
70	130	60	Sand & shale
130	245	115	Lime, red bed & shale
245	460	215	Red bed & shale
460	510	50	Red rock
510	550	40	Anthracite
550	782	232	Shale
782	798	16	Shale & shells
798	1180	382	Shale
1180	1540	360	Shale & shells
1540	1597	57	Broken lime
1597	1653	56	Lime & shale
1653	1700	47	Broken lime
1700	1816	116	Lime
1816	1855	39	Lime & shale
1855	1865	10	Broken sand
1865	1948	83	Lime
1948	2000	52	Lime & shale
2000	2039	39	Lime
2039	2067	28	Broken lime
2067	2142	75	Lime & shale
2142	2212	70	Lime shells & shale
2212	2255	43	Lime & shale
2255	2288	33	Sandy shale
2288	2298	10	Sandy lime
2298	2350	52	Lime
2350	2401	51	Broken lime & shale
2401	2410	9	Broken lime
2410	2442	32	Sandy shale
2442	2456	14	Lime & shale
2456	2564	108	Broken lime & sh.
2564	2567	3	Lime
2567	2630	63	Broken lime & shale
2630	2679	49	Lime
2679	2700	21	Lime & shale
2700	2733	33	Lime
2733	2788	55	Shale
2788	2793	5	Lime
2793	2840	47	Lime
2840	2888	48	Sandy shale
2888	3033	145	Lime
3033	3062	29	Lime & shells
3062	3111	49	Lime
3111	3260	149	Broken lime
3260	3287	27	Broken sand
3287	3301	14	Broken lime & shale
3301	3342	41	Shale
3342	3400	58	Shale with lime streaks
3400	3445	45	Lime & shells
3445	3454	9	Lime
3454	3492	38	Lime & shale
3492	3550	58	Lime
3550	3724	174	Lime & shale
3724	3779	55	Shale
3779	3785½	6½	Shale with streaks Pyrite
3785½	3798	12½	Misener Sand - top 3785½'
3798	3805	7	Sandy lime & chert
3805	3805		TOTAL DEPTH
3805	3802		Correction Total Depth of 3' after removal of floor & sub-structure - measurement to be from cement mat.


Top of Misener Sand corrected to 3782½'.

LEASE Krey, John WELL NO. 13
 LEASE NO. 6492 ACRES 130 A. F. E. NO. 1010
 ELEVATION 1813 PRODUCING DIVISION Southwestern
 LOT SEC. 14 TWP. 24 S RGE. 11 W
 PRCT. Kansas SURVEY _____
 COUNTY Stafford STATE Kansas

LOCATION

1650 FEET NORTH OF SOUTH LINE
 1654 FEET EAST OF WEST LINE
 330 FEET SOUTH OF NORTH LINE
 992 FEET WEST OF EAST LINE

NORTH

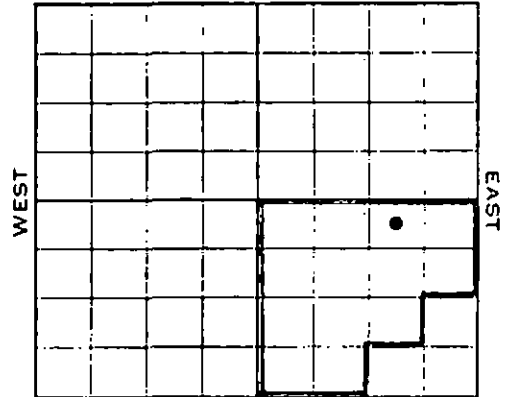

SOUTH

SCALE ¼" = 660 FEET

CASING RECORD

SIZE	WEIGHT	THREAD	MAKE	SET AT	REMARKS
10"	32#	8	L. W.	258	
7"OD	26, 22#	10	SS & LW	3785	
5"OD	21#	10	L. W.	3784	

CASING CEMENTING RECORD

SIZE	SET AT	SACKS USED	GALLONS SETFAST	RESULTS
10"	258	275	None	Good
7"OD	3785	200	"	"
5"OD	3784	30	"	"

LINER RECORD

SIZE	WEIGHT	LENGTH	NO. JOINTS BLANK	NO. JOINTS PERFORATED	SET AT

BRADENHEAD RECORD

MAKE	SIZE	TYPE	REMARKS

INITIAL TORPEDO RECORD

DATE	TOP OF SHOT	BOTTOM OF SHOT	NO. QTS.	REMARKS
12/19/38	3784	3804	5	Shot by Ind. Eastern Torp. Co.

DRILLING COMMENCED November 8, 1938
 DRILLING COMPLETED January 19, 1939
 DRILLED WITH Rotary TOOLS _____
 DRILLED IN WITH Standard TOOLS _____
 FIRST 24 HRS. PRODUCTION - NATURAL _____ BBLs.
 FIRST 24 HRS. PRODUCTION - AFTER SHOT Flowed 1622 BBLs.
 GRAVITY _____, TEMP. _____, GRADE _____
 GAS-ROCK PRESS _____ LBS., VOLUME _____ CU. FT.
 DATE ABANDONED _____ 19

RECEIVED
STATE CORPORATION COMMISSION
NOV - 1 1952
CONSERVATION DIVISION
Wichita, Kansas