


STATE OF KANSAS  
STATE CORPORATION COMMISSION

Form CP-4

Give All Information Completely  
Make Required Affidavit  
Mail or Deliver Report to:  
Conservation Division  
State Corporation Commission  
211 No. Broadway  
Wichita, Kansas

## WELL PLUGGING RECORD

NORTH

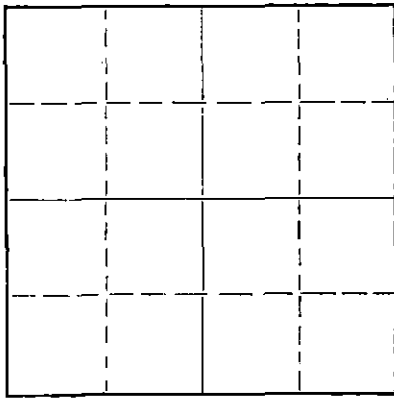

Locate well correctly on above  
Section Plat

Reno County, Sec. 5 Twp. 24S Rge. 4 (E) (W)  
Location as "NE/CNW/SW" or footage from lines C. SW. NE.

Lease Owner Wofford Oil Company

Lease Name Johnson B Well No. 21

Office Address 1016 Union National Building Wichita, Kansas

Character of Well (completed as Oil, Gas or Dry Hole) Dry Hole

Date well completed April 11, 1968

Application for plugging filed April 11, 1968

Application for plugging approved April 11, 1968

Plugging commenced April 11, 1968

Plugging completed April 11, 1968

Reason for abandonment of well or producing formation 7" Surface Pipe  
in well-not sufficient clearance to run pipe inside

If a producing well is abandoned, date of last production 19

Was permission obtained from the Conservation Division or its agents before plugging was commenced? yes

Name of Conservation Agent who supervised plugging of this well Gilbert Toman

Producing formation Depth to top Bottom Total Depth of Well Feet

Show depth and thickness of all water, oil and gas formations.

## OIL, GAS OR WATER RECORDS

## CASING RECORD

FORMATION	CONTENT	FROM	TO	SIZE	PUT IN	PULLED OUT

Describe in detail the manner in which the well was plugged, indicating where the mud fluid was placed and the method or methods used in introducing it into the hole. If cement or other plugs were used, state the character of same and depth placed, from feet to feet for each plug set.

Bottom plug set at 2161 feet-Plug with 1/2 sack cotton seed hulls and 20 sacks cement to 250 feet. Hole filled with mud to 40 feet. Top plug with 1/4 sack of hulls and cement. Filled at hole with cement.

RECEIVED  
STATE CORPORATION COMMISSION  
MAY 1 1968  
CONSERVATION DIVISION  
Wichita, Kansas

(If additional description is necessary, use BACK of this sheet)

Name of Plugging Contractor Henry Wofford Drilling Company, Inc.

Address 1016 Union National Building Wichita, Kansas

STATE OF Kansas, COUNTY OF Sedgewick, ss.

Henry L. Wofford (employee of owner) or (owner or operator) of the above-described well, being first duly sworn on oath, says: That I have knowledge of the facts, statements, and matters herein contained and the log of the above-described well as filed and that the same are true and correct. So help me God.

(Signature) *H. L. Wofford*  
1016 Union National Building Wichita, Kansas

(Address) 1968

Subscribed and sworn to before me this 15th day of April

My commission expires April 27, 1971

*Glenda Fontaine*  
Notary Public.