

STATE OF KANSAS
STATE CORPORATION COMMISSION

Form CP-4

Give All Information Completely
Make Required Affidavit
Mail or Deliver Report to:
Conservation Division
State Corporation Commission
212 No. Market
Wichita, Kansas

WELL PLUGGING RECORD

Reno County, Sec. 5 Twp. 24S Rge. 4 (E) (W)

Location as "NE/CNW/SW" or footage from lines C SW NE

Lease Owner Sterling Drilling Company

Lease Name Johnson "I" Well No. 1

Office Address Box 127, Sterling, Kansas 67579

Character of Well (completed as Oil, Gas or Dry Hole) Dry Hole

Date well completed October 26, 19 66

Application for plugging filed October 26 19 66

Application for plugging approved October 26 19 66


Plugging commenced 6:00 p.m. October 26, 19 66

Plugging completed 11:00 p.m. October 26 19 66

Reason for abandonment of well or producing formation Dry

If a producing well is abandoned, date of last production 19

Was permission obtained from the Conservation Division or its agents before plugging was commenced? Yes

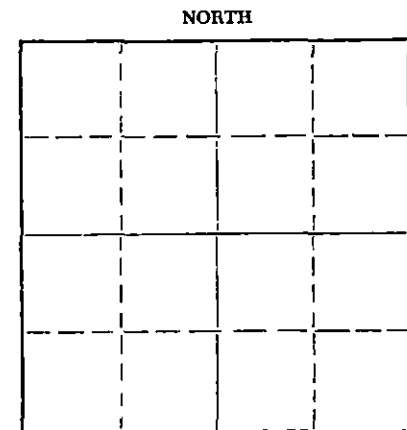

Locate well correctly on above Section Plat

Name of Conservation Agent who supervised plugging of this well Mr. Gilbert Toman, Holyrood, Kansas

Producing formation _____ Depth to top _____ Bottom _____ Total Depth of Well 3405 Feet

Show depth and thickness of all water, oil and gas formations.

OIL, GAS OR WATER RECORDS

CASING RECORD

FORMATION	CONTENT	FROM	TO	SIZE	PUT IN	PULLED OUT
	Casing	0	580	7"	X	

Describe in detail the manner in which the well was plugged, indicating where the mud fluid was placed and the method or methods used in introducing it into the hole. If cement or other plugs were used, state the character of same and depth placed, from _____ feet to _____ feet for each plug set.

Filled hole with heavy mud, Halliburton plug at 560' with 1/4 sack hulls and 10 sacks cement; Halliburton plug at 300' with 1/4 sack hulls and 10 sacks cement; Halliburton plug at 35' with 1/4 sack hulls and 5 sacks cement.

RECEIVED
STATE CORPORATION COMMISSION
NOV 7 1966
CONSERVATION DIVISION
Wichita, Kansas

(If additional description is necessary, use BACK of this sheet)

Name of Plugging Contractor Sterling Drilling Company

Address Box 127, Sterling, Kansas 67579

STATE OF KANSAS, COUNTY OF RICE, ss.

F. A. Wuellner (employee of owner) or (owner or operator) of the above-described well, being first duly sworn on oath, says: That I have knowledge of the facts, statements, and matters herein contained and the log of the above-described well as filed and that the same are true and correct. So help me God. **STERLING DRILLING COMPANY**

(Signature) F. A. Wuellner
Box 127, Sterling, Kansas F. A. Wuellner, Sect.
(Address)

SUBSCRIBED AND SWORN to before me this 29th day of October, 19 66

BERNARD LAUDERMILK, Notary Public
Commission Expires January 22, 1970

Bernard Laudermilk
Bernard Laudermilk, Notary Public.

My commission expires _____

STERLING DRILLING COMPANY
Sterling, Kansas

WELL LOG ----- JOHNSON "I" #1

LOCATED: C SW NE Section 5-24S-4W, Reno County, Kansas

OWNER: Sterling Drilling Company and Ballard & Cordell Corporation
ROTARY DRILLING CONTRACTOR: Sterling Drilling Company

COMMENCED: October 18, 1966

COMPLETED: October 26, 1966

ROTARY TOTAL DEPTH: 3405'

LOG

0 - 200	Sand
200 - 275	Sand & Shale
275 - 585	Shale, Sand & Anhydrite
585 - 2470	Lime & Shale
2470 - 2697	Sand & Lime
2697 - 2905	Lime & Shale
2905 - 3010	Lime
3010 - 3095	Lime & Shale
3095 - 3220	Lime
3220 - 3320	Lime & Shale
3320 - 3374	Lime, Dolomite & Chert
3374 - 3405	Lime T.D.

CASING RECORD

Run 19 joints (568.52') 7" OD casing.
Cemented at 580' K.B. with 300 sacks
Sun-Set Cement. Plug was down at 11:45
p.m..

RECEIVED
STATE CONSERVATION COMMISSION
NOV 7 1966
CONSERVATION DIVISION
Topeka, Kansas

Plugged as follows: Howco plug at
560' with 10 sacks cement; plug at
300' with 10 sacks cement; plug at
35' with 5 sacks cement. Completed
at 11:00 p.m. 10-26-66.