

STATE OF KANSAS
STATE CORPORATION COMMISSION


WELL PLUGGING RECORD

Give All Information Completely
Make Required Affidavit
Mail or Deliver Report to:
Conservation Division
State Corporation Commission
800 Bitting Building
Wichita, Kansas

OR
FORMATION PLUGGING RECORD

Strike out upper line
when reporting plug-
ging off formations.

NORTH

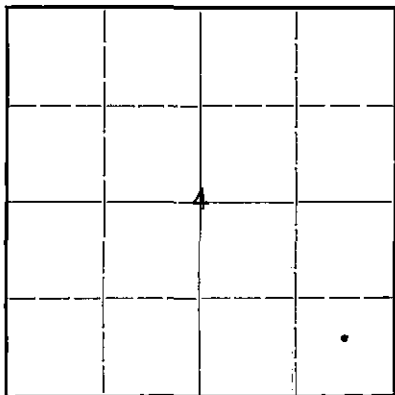

Locate well correctly on above
Section Plat

Reno County. Sec. 4 Twp. 24S Rge. (E) 4 (W)
Location as "NE 1/4 NW 1/4 SW 1/4" or footage from lines. C SE SE
Lease Owner. Shell Oil Company, Inc.
Lease Name. G. H. Welch "B" Well No. 1
Office Address. Box 650, McPherson, Kansas
Character of Well (completed as Oil, Gas or Dry Hole). Oil
Date well completed. 6-16.19.36
Application for plugging filed. 1-20.19.45
Application for plugging approved. 2- 2.19.45
Plugging commenced. 3-21.19.45
Plugging completed. 3-31.19.45
Reason for abandonment of well or producing formation. well depleted

If a producing well is abandoned, date of last production. May 19.44
Was permission obtained from the Conservation Division or its agents before plugging was com-
menced? Yes

Name of Conservation Agent who supervised plugging of this well. Ruel Durkee
Producing formation. Miss lime Depth to top. 3276' Bottom. 3352' Total Depth of Well. 3352 Feet
Show depth and thickness of all water, oil and gas formations.

OIL, GAS OR WATER RECORDS


CASING RECORD

Formation	Content	From	To	Size	Put In	Pulled Out
Miss lime	Oil & Wtr.	3276'	3352'	13"	308'	Left in hole
				7"	3362'	2482'

Describe in detail the manner in which the well was plugged, indicating where the mud fluid was placed and the method or methods used in introducing it into the hold. If cement or other plugs were used, state the character of same and depth placed, from _____ feet to _____ feet for each plug set.

3379' To 3352' PB W/14 sacks of cement
This work done prior to start of abandonment
3352' To 315' PB W/Mud
315' To 300' Rock Bridge
300' To 258' PB W/30 sacks of cement
258' To 10' PB W/Mud
10' To 0' Capped W/10 sacks of cement

FILE 4 24-46
BOOK PAGE 4 LINE 1

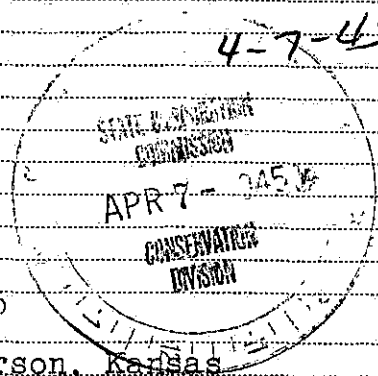

(If additional description is necessary, use BACK of this sheet)
Correspondence regarding this well should be addressed to R. T. McNally
Address. Box 650, McPherson, Kansas

STATE OF Kansas, COUNTY OF McPherson, ss.
R. T. McNally, Sup't. (employee of owner) or (owner or operator) of the above-described well,
being first duly sworn on oath, says: That I have knowledge of the facts, statements, and matters herein contained and the log of the above-
described well as filed and that the same are true and correct. So help me God.

(Signature) R. T. McNally
Box 650, McPherson, Kansas (Address)

SUBSCRIBED AND SWORN to before me this 5th day of April, 1945
J. S. White
Notary Public.

My commission expires Dec. 28th. 1946

WELL LOG

WELL G. H. Welch "B" No. 1
LOCATION C SE SE, SEC. 4-24S-4W
 650' SE: 650' EL

CASING RECORD

13" Cemented @308' W/300 sax
 7" Cemented @3362' W/500 sax

- 0 190 Sand
- 270 Shale & gyp
- 308 Hard rock
- 735 Shale & shells
- 780 Sandy lime & shale breaks
- 863 Sandy lime & lime shells
- 920 Shale & lime shells
- 938 Lime
- 945 Red rock
- 1040 Broken lime
- 1048 Red rock
- 1088 Lime & shale breaks
- 1152 Lime & shell breaks
- 1240 Broken lime
- 1300 Shale & shells
- 1310 Broken lime
- 1419 Shale & shells
- 1455 Shale
- 1550 Shale & shells
- 1605 Shale
- 1865 Shale & shells
- 1886 Lime
- 1893 Shale & lime
- 1946 Lime & shale breaks
- 1948 SLC
- 1986 Shale
- 2003 Lime
- 2045 Shale & lime shells
- 2062 Lime
- 2095 Broken lime
- 2120 Lime
- 2132 Shale & lime shells
- 2237 Shale & shells
- 2310 Shale & lime shells
- 2335 Lime
- 2346 Shale & shells
- 2378 Shale & lime shells
- 2441 Shale & shells
- 2450 Shale
- 2499 Lime
- 2510 Lime & shale breaks
- 2525 Shale & limey shale
- 2572 Sandy lime & shale
- 2590 Lime
- 2623 Broken lime
- 2678 Hard lime
- 2687 Broken sandy lime
- 2703 Lime
- 2735 Sandy lime
- 2742 Broken lime
- 2762 Lime hard
- 2847 Lime
- 2853 Lime hard
- 2862 Sandy lime
- 2903 Lime hard
- 2928 Lime
- 2935 Sand
- 2986 Lime
- 2999 Lime hard
- 3002 Lime
- 3020 Shale
- 3048 Lime
- 3074 Shale & lime breaks
- 3123 Lime & shale breaks

- 3186 Shale & lime breaks
- 3198 Shale & lime breaks
- 3218 Lime
- 3224 Shale
- 3270 VC shale
- 3280 Shale & lime breaks
- 3368 Chat
- 3363 SLC
- 3363 Chat
- 3379 Chat - TD

COMPLETION: June 16, 1936.
 ELEVATION: 1472'
 DISTRICT: Burrton (formerly
 Patterson)
 COUNTY: Reno
 STATE: Kansas

NOTE: October 4, 1940

3352 TD PB

Gun perforated from 3280'
 to 3351' with 100 holes.

PLUGGING
 FILE 4-24-4W
 BOOK PAGE 4 LINE 1