


Give All Information Completely  
Make Required Affidavit  
Mail or Deliver Report to:  
Conservation Division  
State Corporation Commission  
211 No. Broadway  
Wichita, Kansas

WELL PLUGGING RECORD

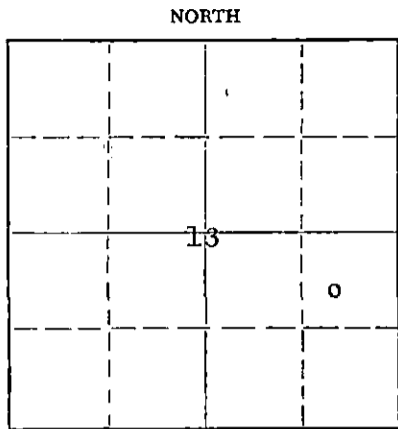

Locate well correctly on above Section Plat

Kingman County. Sec. 13 Twp. 28S Rge. (E) 6 (W)  
Location as "NE/CNW/SE" or footage from lines SW NE SE  
Lease Owner Lario Oil & Gas Company  
Lease Name Clouse Well No. 4  
Office Address 301 S. Market, Wichita 2, Kansas  
Character of Well (completed as Oil, Gas or Dry Hole) \_\_\_\_\_  
Date well completed October 8, 1958  
Application for plugging filed (Verbal) October 8, 1958  
Application for plugging approved " October 8, 1958  
Plugging commenced October 8, 1958  
Plugging completed October 8, 1958  
Reason for abandonment of well or producing formation Dry Hole  
If a producing well is abandoned, date of last production \_\_\_\_\_ 19\_\_\_\_  
Was permission obtained from the Conservation Division or its agents before plugging was commenced? Yes

Name of Conservation Agent who supervised plugging of this well Fred Hampel  
Producing formation \_\_\_\_\_ Depth to top \_\_\_\_\_ Bottom \_\_\_\_\_ Total Depth of Well 3969 Feet  
Show depth and thickness of all water, oil and gas formations.

OIL, GAS OR WATER RECORDS

CASING RECORD

FORMATION	CONTENT	FROM	TO	SIZE	PUT IN	PULLED OUT
				10 3/4"	292'	None

Describe in detail the manner in which the well was plugged, indicating where the mud fluid was placed and the method or methods used in introducing it into the hole. If cement or other plugs were used, state the character of same and depth placed, from \_\_\_\_\_ feet to \_\_\_\_\_ feet for each plug set.

Set plug at 270' with 1/3 sack hulls and 20 sacks cement on top. Set plug at 40' with 1/3 sack hulls and 10 sacks cement.

(If additional description is necessary, use BACK of this sheet)

Name of Plugging Contractor Gabbert-Jones Drilling Co., Inc.  
Address Wichita, Kansas

STATE OF Kansas, COUNTY OF Sedgwick, ss.  
Leo Ross (employee of owner) or (owner or operator) of the above-described well, being first duly sworn on oath, says: That I have knowledge of the facts, statements, and matters herein contained and the log of the above-described well as filed and that the same are true and correct. So help me God.

(Signature) Leo Ross  
301 S. Market, Wichita, Kansas  
(Address)

SUBSCRIBED AND SWORN TO before me this 13th day of October, 19 58

My commission expires July 21, 1962

Francis Sealy  
Notary Public.  
STATE CORPORATION COMMISSION

PLUGGING  
FILE SEC 13 T. 28 R. 6W  
BOOK PAGE 136 LINE 14

OCT 14 1958  
10-14-58  
CONSERVATION DIVISION  
WICHITA, KANSAS

15-095-01551-0000

LARIO OIL & GAS COMPANY  
Clouse No. 4  
SW NE SE Sec. 13-28S-6W  
Kingman County, Kansas

Date Commenced: Sept. 25, 1958  
Date Completed: Oct. 8, 1958

Drilling Contractor - Gabbert-Jones Drilling Co., Inc.  
Total Depth - 3969'  
I.P. - Dry & Abandoned

Casing Record:  
10 3/4" 308' Set @ 292'  
Cem. w/ 300 sacks

<u>Formation</u>	<u>Depth</u>	<u>GEOLOGICAL TOPS</u>		
Surface soil & sand	20	Elevation	1448 G.L.	1459 R.B.
Post rock, shale & sand	70	Heebner	2796	-1337
Red bed & shells	430	Brown Lime	3034	-1575
Anhydrite	460	Lansing	3068	-1609
Shale & shells	765	Base K.C.	3537	-2078
Anhydrite	900	Marmaton	3601	-2242
Lime	1190	Cherokee	3704	-2345
Lime & shale	1385	Mississippi Rubble		
Lime	1430	Zone	3858	-2399
Shale & shells	2060	Mississippi Limestone	3912	-2453
Lime & shale	3082	Rotary T.D.	3969	-2510
Lime	3472			
Lime & shale	3643			
Lime	3762			
Lime & shale	3863			
Lime	3895			
Lime & chert	3921			
Lime	3969			

STATE CORP. COMMISSION

OCT 14 1958

CONSERVATION DIVISION  
Wichita, Kansas

PLUGGING	
FILE SEC	13 T. 28 R. 6W
BOOK PAGE	136 LINE 14