

Give All Information Completely
Make Required Affidavits
Mail or Deliver Report to:
Conservation Division
State Corporation Commission
1101 No. Broadway
Wichita, Kansas

WELL PLUGGING RECORD

KINGMAN County. Sec. 18 Twp. 28S Rge. 6W (X) (W)

Location as "NE/CNW%SW%" or footage from lines C NW NW

Lease Owner PETROLEUM, INC.

Lease Name GREENLEAF "C" Well No. 1

Office Address ROUTE 2, GREAT BEND, KANSAS

Character of Well (completed as Oil, Gas or Dry Hole) DRY HOLE

Date well completed MARCH 12, 19 62

Application for plugging filed MARCH 12, 19 62

Application for plugging approved MARCH 12, 19 62


Plugging commenced MARCH 12, 19 62

Plugging completed MARCH 12, 19 62

Reason for abandonment of well or producing formation NO PRODUCIBLE FORMATIONS

If a producing well is abandoned, date of last production NONE 19

Was permission obtained from the Conservation Division or its agents before plugging was commenced? YES

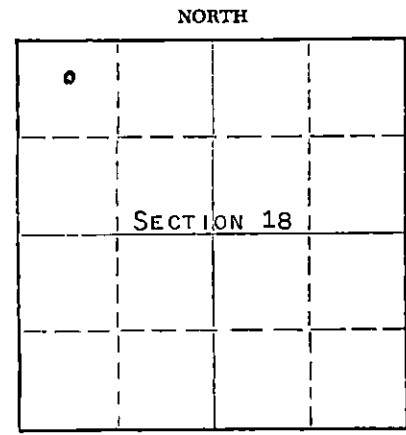

Locate well correctly on above Section Plat

Name of Conservation Agent who supervised plugging of this well FRED HAMPEL

Producing formation --- Depth to top --- Bottom --- Total Depth of Well 2918 Feet

Show depth and thickness of all water, oil and gas formations.

OIL, GAS OR WATER RECORDS

CASING RECORD

FORMATION	CONTENT	FROM	TO	SIZE	PUT IN	PULLED OUT
				8-5/8"	256'	NONE

Describe in detail the manner in which the well was plugged, indicating where the mud fluid was placed and the method or methods used in introducing it into the hole. If cement or other plugs were used, state the character of same and depth placed, from --- feet to --- feet for each plug set.

MUDDED UP WITH HEAVY MUD TO 240' FOLLOWED BY WOODEN PLUG AND 1/2 SACK HULLS. PLACED 20 SACKS CEMENT THROUGH DRILL PIPE ONTO HULLS. MUDDED UP WITH HEAVY MUD TO 40' FOLLOWED BY WOODEN PLUG, 1/2 SACK HULLS, AND TEN (10) SACKS CEMENT TO BASE OF WELL CELLAR. 2 SACKS CEMENT IN RAT HOLE.

RECEIVED
STATE CORPORATION COMMISSION

APR 9 1962
4-9-62
CONSERVATION DIVISION
Wichita, Kansas

(If additional description is necessary, use BACK of this sheet)
Name of Plugging Contractor GARVEY DRILLING COMPANY
Address ROUTE 2, GREAT BEND, KANSAS

STATE OF KANSAS, COUNTY OF BARTON, ss.
DON SEARLE (employee of owner) or (owner) of the above-described well, being first duly sworn on oath, says: That I have knowledge of the facts, statements, and matters herein contained and the log of the above-described well as filed and that the same are true and correct. So help me God.

(Signature) Don Searle
ROUTE 2, GREAT BEND, KANSAS
(Address)

SUBSCRIBED AND SWORN TO before me this 5TH day of APRIL, 19 62

Arthur J. Miles
Notary Public.

My commission expires APRIL 14, 1963.



WELL LOG

15-095-01328-0000

COMPANY PETROLEUM, INCORPORATED

SEC. 18 T-28S R. 6W

FARM GREENLEAF "C" NO. 1

LOC. C-NW, NW,


TOTAL DEPTH 2918'

COUNTY KINGMAN CO., KANSAS

COMM. March 5, 1962

COMP. March 12, 1962

CONTRACTOR GARVEY DRILLING COMPANY

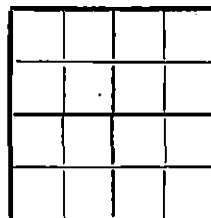

CASING 8-5/8" @ 256' w/175 sax.

ELEVATION 1519' DF

PRODUCTION D & A

FIGURES INDICATE BOTTOM OF FORMATIONS

140	Surface soil, red bed & shale
256	Shale & red bed
960	Shale & shells
1090	Lime & shale
1635	Lime
2560	Shale & lime
2900	Lime & shale
2918	Lime
2918	T. D.

RECEIVED
STATE CORPORATION COMMISSION

APR 9 1962

CONSERVATION DIVISION
Wichita, Kansas

State of KANSAS }
County of BARTON } ss

I, VERNE A. MORRIS of GARVEY DRILLING COMPANY

upon oath state the above and foregoing is a true and correct copy of the log of the #1 GREENLEAF "C" well.

Subscribed and sworn to before me this 28th day of March 19 62

My Commission Expires: April 14, 1963

Verne A. Morris
Arthur J. Gules
NOTARY PUBLIC