

STATE OF KANSAS  
STATE CORPORATION COMMISSION


## WELL PLUGGING RECORD

Give All Information Completely  
Make Required Affidavit  
Mail or Deliver Report to:  
Conservation Division  
State Corporation Commission  
800 Biting Building  
Wichita, Kansas

OR

FORMATION PLUGGING RECORD Strike out upper line when reporting plugging off formations.

NORTH

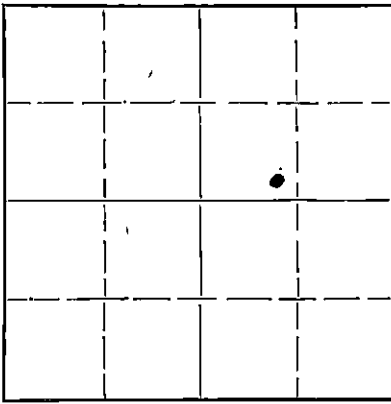

Locate well correctly on above  
Section Plat

Stafford County. Sec. 14 Twp. 24S Rge. (E) 11 (W) 11  
Location as "NE $\frac{1}{4}$ NW $\frac{1}{4}$ SW $\frac{1}{4}$ " or footage from lines NE $\frac{1}{4}$ , 330' fm Sth, 990' fm West line  
Lease Owner Sinclair Oil & Gas Co  
Lease Name John Krey Well No. 3  
Office Address Box 521, Tulsa, Okla.  
Character of Well (completed as Oil, Gas or Dry Hole) Oilwell  
Date well completed July 27 19 38  
Application for plugging filed June 22 19 50  
Application for plugging approved June 23 19 50  
Plugging commenced July 27 19 50  
Plugging completed Aug 3 19 50  
Reason for abandonment of well or producing formation Production depleted  
If a producing well is abandoned, date of last production Dec 1949  
Was permission obtained from the Conservation Division or its agents before plugging was commenced? Yes

Name of Conservation Agent who supervised plugging of this well Eldon Petty  
Producing formation Misener- Viola Depth to top 3805 Bottom 3810 Total Depth of Well 3810 Feet  
Show depth and thickness of all water, oil and gas formations.

## OIL, GAS OR WATER RECORDS

## CASING RECORD

Formation	Content	From	To	Size	Put In	Pulled Out
<u>Viola lime</u>	<u>dry</u>	<u>3805</u>	<u>3810</u>	<u>13"</u>	<u>275'</u>	<u>0</u> <del>275'</del>
				<u>7"</u>	<u>3779'</u>	<u>2713'</u> <del>1005'</del>

Describe in detail the manner in which the well was plugged, indicating where the mud fluid was placed and the method or methods used in introducing it into the hole. If cement or other plugs were used, state the character of same and depth placed, from \_\_\_\_\_ feet to \_\_\_\_\_ feet for each plug set.

3810-3770 crushed rock  
3770-3751 cement 5sx  
3751-275 heavy mud  
275-265 rock bridge  
265-238 cement 25sx  
238-25 heavy mud  
25-15 rock bridge  
15 - btm cellar cement 15sx

RECEIVED

Conservation

AUG 9 - 1950

8-9-50

STATE CORPORATION  
COMMISSION  
KANSAS

(If additional description is necessary, use BACK of this sheet)

Correspondence regarding this well should be addressed to Mr E.H. Gibbons  
Address Box 551, Chase, Kans

STATE OF Kansas COUNTY OF Rice, ss.  
I, E.H. Gibbons (employee of owner) or (owner) of the above-described well,  
being first duly sworn on oath, says: That I have knowledge of the facts, statements, and matters herein contained and the log of the above-described well as filed and that the same are true and correct. So help me God.

(Signature)

E.H. Gibbons

Box 551, Chase, Kans


(Address)

SUBSCRIBED AND SWORN to before me this 8th day of August 19 50

My commission expires

Aug. 22 1953

B.R. Ritterhouse  
Notary Public.

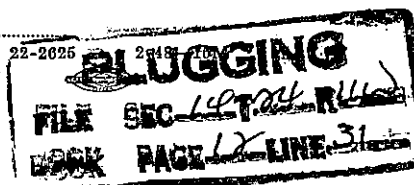

15-185-10329-0000

Well Log  
Sinclair Oil & Gas Co

John Krey # 3  
NE/4, 14-24S-11W, Stafford Co., Kas.  
330' fm Sth, 990' fm West  
Elev. 1813

Began drlg 6/11/1950  
Completed drlg 7/27/1950  
TD 3810' Viola.

13" set at 275' w/ 225 sx  
7" set at 3779' w/100 sx

Sand & Shale	275'
Red Bed	530
Shale & Shells	1485
Lime	1850
Broken Lime	1935
Lime	2235
Shale	2285
Shale & Lime	2345
Shale	2435
Shale & Shells	2520
Shale	2560
Lime	2600
Shale & Lime	2895
Shale & Shells	2950
Lime & Shale	3040
Lime	3255
Shale & Lime	3425
K.C. Lime	3470
Lime	3638
Lime & Shale	3767
Shale	3785
Meisner Sand	3805
Viola Lime	3810 TD
top Meisner Lime	3782
top " Sand	3785

**PLUGGING**  
FILE SEC 14T-24R-11W  
BOOK PAGE 12 LINE 31

RECEIVED  
Oil Division  
JUN 23 1950  
STATE CORPORATION  
COMMISSION  
KANSAS