


WELL PLUGGING RECORD

Give All Information Completely
Make Required Affidavit
Mail or Deliver Report to:
Conservation Division
State Corporation Commission
800 Bittling Building
Wichita, Kansas

NORTH

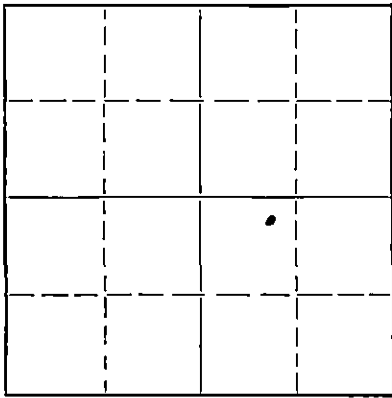

Locate well correctly on above
Section Plat

Stafford County, Sec. 14 Twp. 24S Rge. 11 (E) W (W)
Location as "NE/CNW/4SW/4" or footage from lines CNENWSE
Lease Owner The Pure Oil Company
Lease Name John Krey Well No. 5
Office Address Box 271 - Tulsa, Oklahoma
Character of Well (completed as Oil, Gas or Dry Hole) Oil
Date well completed 7-23 19.38
Application for plugging filed 9-11 19.52
Application for plugging approved 9-13 19.52
Plugging commenced 9-24 19.52
Plugging completed 10-30 19.52
Reason for abandonment of well or producing formation No longer profitable
If a producing well is abandoned, date of last production 10-8 19.51
Was permission obtained from the Conservation Division or its agents before plugging was commenced? Yes

Name of Conservation Agent who supervised plugging of this well M. A. Rives
Producing formation Misener Sand Depth to top 3790 Bottom 3807 Total Depth of Well 3814 Feet
Show depth and thickness of all water, oil and gas formations.

OIL, GAS OR WATER RECORDS

CASING RECORD

Formation	Content	From	To	Size	Put In	Pulled Out
Misener Sand	Oil	3790	3807	10"	270	
				7"	3790	2759

Describe in detail the manner in which the well was plugged, indicating where the mud fluid was placed and the method or methods used in introducing it into the hole. If cement or other plugs were used, state the character of same and depth placed, from feet to feet for each plug set.

Filled with crushed rock 3814' to 3778'. Cemented with 5 sacks 3778' to 3748'.
Mudded 3748' to 365'. Rock bridge 365' to 350'. Mudded 350' to 300'. Rock bridge
300' to 290'. Cemented 290' to 282'. Crushed rock 282' to 270'. hole bridged at
160'. 7 sacks cement 160' to 139'. Left hole open for fresh water well for land
owner.

11-5-52

FILED
STATE OF KANSAS
OCT 10 1952
CONSERVATION DIVISION
WICHITA, KANSAS

(If additional description is necessary, use BACK of this sheet)

Name of Plugging Contractor Forbes Casing Pulling Company
Address Box 221 - Great Bend, Kansas

STATE OF Oklahoma, COUNTY OF Tulsa, ss.
H. E. Schafer (employee of owner) of the above-described well,
being first duly sworn on oath, says: That I have knowledge of the facts, statements, and matters herein contained and the log of the above-described well as filed and that the same are true and correct. So help me God.


(Signature) H. E. Schafer

Box #271, Tulsa, Oklahoma
(Address)

SUBSCRIBED AND SWORN to before me this 3 day of November, 19 52

My commission expires September 7, 1954

Notary Public.

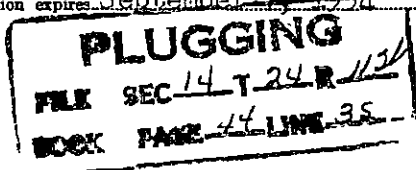

THE PURE OIL COMPANY
WELL LOG
AND RELATED DATA

15-185-10337-0000

LOG			
TOP	BOTTOM	THICKNESS	FORMATION
0	110	110	Sand & Red bed
110	190	80	Sand & clay
190	285	95	Red bed
285	376	91	Shale
376	550	174	Shale & red bed
550	600	50	Gyp & shale
600	780	180	Red bed & shale
780	850	70	Shale
850	900	50	Shale & lime shells
900	1190	290	Shale
1190	1250	60	Red rock & shale
1250	1410	160	Shale
1410	1520	110	Sandy shale
1520	1570	50	Shale & shells
1570	1685	115	Lime
1685	1725	40	Broken lime
1725	1894	169	Lime
1894	1970	76	Broken lime & sand
1970	2200	230	Lime
2200	2490	290	Broken lime
2490	2551	61	Shale
2551	2640	89	Broken shale & lime
2640	2690	50	Broken lime
2690	2775	85	Lime
2775	2782	7	Shale
2782	2960	178	Broken lime
2960	3022	62	Lime
3022	3082	60	Broken lime
3082	3165	83	Lime
3165	3233	68	Broken lime
3233	3263	30	Lime
3263	3310	47	Broken lime
3310	3345	35	Lime
3345	3394	49	Broken lime & shale
3394	3579	185	Lime- top of Kansas City Lime 3402'
3579	3622	43	Broken lime
3622	3686	64	Lime
3686	3742	56	Broken lime & shale
3742	3790 $\frac{1}{2}$	48 $\frac{1}{2}$	Shale & lime
3790 $\frac{1}{2}$	3794	3 $\frac{1}{2}$	Sand- top of Misener Sand 3790' -
3794	3807	13	Sand- hole filled 1000' oil 3794- 3797'
3807	3810	3	Sand & chert
3810	3811	1	Chert
3811	3817	6	Shale & lime
3817	3814		Correction of 3' after taking out floor & sub-structure - measurement to be from cement mat
	3814		TOTAL DEPTH

NOTE- Top of Misener Sand corrected to 3787 $\frac{1}{2}$ '

(OVER)

PLUGGING
FILE 15-185-10337-0000
BOOK PAGE 44 LINE 35

LEASE		WELL NO. 5	
LEASE NO. 6492	ACRES 130	A. F. E. NO. 999	
ELEVATION 1818		PRODUCING DIVISION Southwestern	
LOT SEC. 14	TWP. 24 S	RGE. 11 W	
PRCT. Kansas		SURVEY	
DIST. Stafford		STATE Kansas	

LOCATION

2312 FEET NORTH OF SOUTH LINE
992 FEET EAST OF WEST LINE
330 FEET SOUTH OF NORTH LINE
1654 FEET WEST OF EAST LINE

NORTH

WEST EAST

14 5

SOUTH

SCALE $\frac{1}{4}$ "=660 FEET

CASING RECORD					
SIZE	WEIGHT	THREAD	MAKE	SET AT	REMARKS
10"	35#	8	L. W.	270	
7"OD	22#	10	S. S.	3790	

CASING CEMENTING RECORD				
SIZE	SET AT	SACKS USED	GALLONS SETFAST	RESULTS
10"	270	275	None	Good
7"OD	3790	200	"	"

LINER RECORD					
SIZE	WEIGHT	LENGTH	NO. JOINTS BLANK	NO. JOINTS PERFORATED	SET AT

BRADENHEAD RECORD			
MAKE	SIZE	TYPE	REMARKS

INITIAL TORPEDO RECORD				
DATE	TOP OF SHOT	BOTTOM OF SHOT	NO. QTS.	REMARKS
7/18/38	3800	3810	5	Shot by Eastern Torpedo Co.
11' savings after shot				

DRILLING COMMENCED	June 11,	19	38
DRILLING COMPLETED	July 23,	19	38
DRILLED WITH	Rotary	TOOLS	
DRILLED IN WITH	Standard	TOOLS	
FIRST 24 HRS. PRODUCTION-NATURAL		BBLS.	
FIRST 24 HRS. PRODUCTION-AFTER SHOT	1961	BBLS.	
GRAVITY		, TEMP. , GRADE	
GAS-ROCK PRESS		LBS., VOLUME	31,900 CU. FT.
DATE ABANDONED		19	

7ED
COMMUNICATIONS

3 1952

ION DIV.
a, Kansas