


WELL PLUGGING RECORD

Give All Information Completely
Make Required Affidavit
Mail or Deliver Report to:
Conservation Division
State Corporation Commission
211 No. Broadway
Wichita, Kansas

NORTH

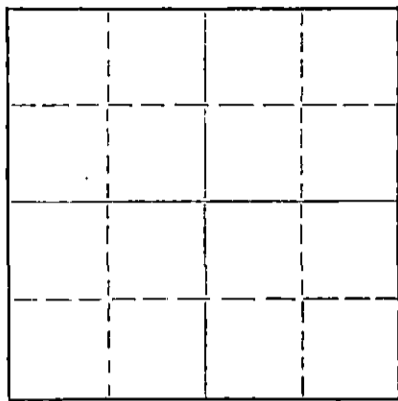

Locate well correctly on above
Section Plat

Edwards County. Sec. 28 Twp. 24S Rge. 18 (X) (W)
Location as "NE/CNWxSWx" or footage from lines SE SE SW
Lease Owner Home Stake Production Co.
Lease Name Brill Well No. #1
Office Address 503 Jenkins, Tulsa, Oklahoma
Character of Well (completed as Oil, Gas or Dry Hole) Dry Hole
Date well completed 7/16/56 19
Application for plugging filed 7/15/56 19
Application for plugging approved 7/15/56 19
Plugging commenced 7/16/56 19
Plugging completed 7/16/56 19
Reason for abandonment of well or producing formation Dry Hole

If a producing well is abandoned, date of last production _____ 19____
Was permission obtained from the Conservation Division or its agents before plugging was commenced? Yes

Name of Conservation Agent who supervised plugging of this well M. A. Rives
Producing formation _____ Depth to top _____ Bottom _____ Total Depth of Well 4950 Feet
Show depth and thickness of all water, oil and gas formations.

OIL, GAS OR WATER RECORDS

CASING RECORD

FORMATION	CONTENT	FROM	TO	SIZE	PUT IN	PULLED OUT
				8 5/8"	281'	None

Describe in detail the manner in which the well was plugged, indicating where the mud fluid was placed and the method or methods used in introducing it into the hole. If cement or other plugs were used, state the character of same and depth placed, from _____ feet to _____ feet for each plug set.

PLUGGING RECORD

Filled from 4950' to 285' with heavy mud. Set wood plug at 285' with hulls and 20 sacks cement through drill pipe. Filled from 245' to 35' with heavy rotary mud. Set wood plug at 35' with hulls and 10 sacks cement up to cellar - 0'.
Job completed at 6:30 AM 7/16/56.

7-21-56

RECEIVED
STATE CORPORATION COMMISSION
JUL 21 1956
CONSERVATION DIVISION
WICHITA, KANSAS

(If additional description is necessary, use BACK of this sheet)

Name of Plugging Contractor Sierra petroleum Co., Inc.
Address 420 West Douglas, Wichita, Kansas

STATE OF KANSAS, COUNTY OF RUSSELL, ss.
C. T. Honaker (employee of owner) or (owner or operator) of the above-described well, being first duly sworn on oath, says: That I have knowledge of the facts, statements, and matters herein contained and the log of the above-described well as filed and that the same are true and correct. So help me God.

(Signature) C. T. Honaker

(Address) _____

SUBSCRIBED AND SWORN to before me this 18th day of July, 1956

My commission expires

10/17/59

Leroy Dietz

Notary Public.

PLUGGING
FILE SEC 28 T 24 R 18W
BOOK PAGE 81 LINE 32

15-047-00050 0000

Home Stake Production Co.
Brill #1

SE SE SW 28-24S-18W
Edwards County, Kansas

Sierra Petroleum Co., Inc.(Contr.)

Elev: 2160DF

Total Depth: 4950'

Comm: 6/26/56
Comp: 7/16/56

Casing 8 5/8" @ 281'
Cement 175 sacks Bulk

FORMATION	DEPTH
Sand	85
Shale	550
Shale & shells - Red bed	1155
Anhydrite	1285
Shale & shells	1625
Shale, lime & shells	2045
Lime & shale	2285
Lime	2390
Lime & shale	2500
Lime	2615
Shale & Lime	3987
Lime	4530
Cherty Conglomerate	4550
Shale - (Cherty)	4579
Sand (hard)	4600
Sand & shale	4602
Shale, sand & chat	4646
Lime	4660
Lime (Cherty)	4736
Lime	4792
Limed dolomite	4816
Lime	4835
Lime, shale & chert	4867
Lime	4913
Simpson	4916
Arbuckle	4950

2160
1285
875

4950
2160
790

3846
2160
636

4916
2160
796

Tops:	Hebner	3846
	Brown Lime	3969
	Lansing/KC	3979
	Viola	4623
	Arbuckle	4916

RECEIVED
STATE CORPORATE COMMISSION
JUL 21 1956
CONSERVATION DIVISION
Wichita, Kansas

STATE OF KANSAS)
) ss:
COUNTY OF RUSSELL)

I hereby certify that the above information is true and correct to the best of my knowledge.

C. P. Honaker

Subscribed and sworn to before me this 18th day of July, 1956.

Leroy Duetz
Notary Public

My commission expires: 10/17/59

PLUGGING
FILE SEC. 28 T. 24 R. 18W
BOOK PAGE 81 LINE 32