


Give All Information Completely
Make Required Affidavit
Mail or Deliver Report to:
Conservation Division
State Corporation Commission
800 Bittig Building
Wichita, Kansas

WELL PLUGGING RECORD

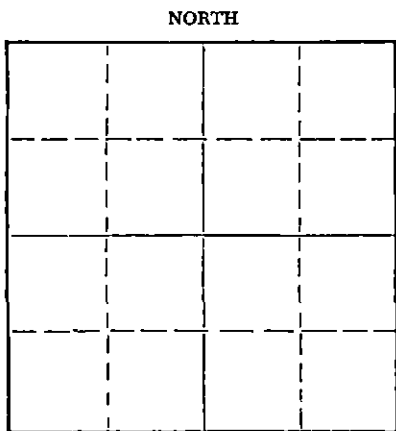

Locate well correctly on above Section Plat

Kingman County. Sec. 28 Twp. 28 Rge. (E) 5 (W)
Location as "NE/CNW/SW" or footage from lines SW SW SE
Lease Owner Artnell Co. and Shawver-Armour, Inc.
Lease Name Bolinger Well No. 1
Office Address 1st Floor, Petroleum Building, Wichita, Kansas
Character of Well (completed as Oil, Gas or Dry Hole) Dry Hole
Date well completed 9-8 19 55
Application for plugging filed 9-8 19 55
Application for plugging approved 9-8 19 55
Plugging commenced 9-8 19 55
Plugging completed 9-8 19 55
Reason for abandonment of well or producing formation Dry Hole

If a producing well is abandoned, date of last production None 19
Was permission obtained from the Conservation Division or its agents before plugging was commenced? Yes

Name of Conservation Agent who supervised plugging of this well Dwight Lilly
Producing formation Mississippian Depth to top 3915 Bottom 3952 Total Depth of Well 3952 Feet
Show depth and thickness of all water, oil and gas formations.

OIL, GAS OR WATER RECORDS

CASING RECORD

FORMATION	CONTENT	FROM	TO	SIZE	PUT IN	PULLED OUT
Surface	Water	0	169'	8-5/8	169'	None

Describe in detail the manner in which the well was plugged, indicating where the mud fluid was placed and the method or methods used in introducing it into the hole. If cement or other plugs were used, state the character of same and depth placed, from feet to feet for each plug set.

3952-165 Fill Hole w/ heavy mud
165 Permanent Rock Plug and 15 sx cement thru drill pipe
165- 25 Fill w/heavy mud
25 Permanent rock plug and 5 sx cement to bottom of cellar

(If additional description is necessary, use BACK of this sheet)

Name of Plugging Contractor
Address

STATE OF Kansas COUNTY OF Sedgwick, ss.
James Armour (employee of owner) or (owner or operator) of the above-described well, being first duly sworn on oath, says: That I have knowledge of the facts, statements, and matters herein contained and the log of the above-described well as filed and that the same are true and correct. So help me God.

(Signature) James Armour
817 Central Building
(Address)

SUBSCRIBED AND SWORN to before me this 12th day of September, 19 55

My commission expires Mar 30, 1957

Rosemary Penrose
Rosemary Penrose Notary Public.

RECEIVED
PLUGGING
FILE SEC 28 T 28 R SW
BOOK PAGE 148 LINE 13
9-17-55
CONSERVATION DIVISION
Wichita, Kansas

15-095-00069-0000

DRILLING LOG

COMPANY: Artnell Company
CONTRACTOR: Shawver-Armour, Inc.
FARM NAME: Bollinger #1
COMMENCED: September 8, 1955
COMPLETED: September 29, 1955

Location: SW SW SE
Sec. 28-28-5W
Kingman County
Elevation: 1430 FT

CASING RECORD

169' 8-5/8" w/170 ex cost.

FORMATION	FROM	TO
Redrock & Cleachey	0	40
Sand & Shale		168
Red Bed		285
Shale & Salt		800
Shale & Shells		1060
Lime & Shale Stks		1210
Lime & Shale		1730
Shale & Lime		2345
Lime & Shale		2735
Sandy Shale & Lime		2910
Shale & Lime		3100
Shale w/Lime Stks		3203
Shale & Lime		3390
Lime		3546
Shale w/Lime Stks		3707
Lime & Shale		3768
Shale w/Lime Stks		3844
Shale		3895
Shale & Lime		3952 RTD

TOP
Mississippian 3915

STATE OF KANSAS)
SEDENWICK COUNTY)

I, James Armour, do hereby certify that the above is a true and correct copy of the log on the above captioned well, as shown on the daily drilling reports.

SHAWVER-ARMOUR, INC.

PLUGGING
WEL SEC 28 T 28 R 5W
BOOK PAGE 148 LINE 13

By: James Armour
Joe's Armour, Sec-Treas.

Subscribed and sworn to before me this 14 day of September 1955

Rosemary Penryse
Rosemary Penryse, Notary Public

My commission expires Mar 30, 1957

NOTARY PUBLIC
KANSAS
NOTARY DIVISION
Topeka, Kansas