


15-095-01072-0000

STATE OF KANSAS
STATE CORPORATION COMMISSION
CONSERVATION DIVISION
P. O. BOX 17027
WICHITA, KANSAS 67217

FORM CP-4

WELL PLUGGING RECORD

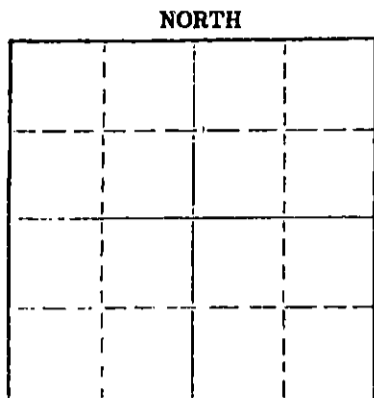

Locate well correctly on above Section Plat

Kingman County, Sec. 28 Twp. 28 Rge. 5W (E) (W)
Location as "NE/CNWSW4" or footage from lines NE NW NE

Lease Owner Icar Addie
 Lease Name Bowling Well No. 2
 Office Address Drawer 8038 Wichita Kansas 67208
 Character of Well (completed as Oil, Gas or Dry Hole) Oil
 Date well completed 10-1 19 74
 Application for plugging filed 6-26 19 74
 Application for plugging approved 6-27 19 74
 Plugging commenced 7-16 19 74
 Plugging completed 7-19 19 74
 Reason for abandonment of well or producing formation _____

If a producing well is abandoned, date of last production _____ 19____
 Was permission obtained from the Conservation Division or its agents before plugging was commenced? Yes

Name of Conservation Agent who supervised plugging of this well Brunel Ribenstein
 Producing formation _____ Depth to top _____ Bottom _____ Total Depth of Well 3830' Feet
 Show depth and thickness of all water, oil and gas formations.

OIL, GAS OR WATER RECORDS

CASING RECORD

| FORMATION | CONTENT | FROM | SIZE | PUT IN | PULLED OUT |
|-----------|---------|------|--------|--------|------------|
| | | | 5 1/2" | | 2513' |
| | | | | | |
| | | | | | |
| | | | | | |
| | | | | | |
| | | | | | |
| | | | | | |
| | | | | | |

STATE RECEIVED
 JUL 22 1974
 CONSERVATION DIVISION
 Wichita, Kansas

Describe in detail the manner in which the well was plugged, indicating where the mud fluid was placed and the method or methods used in introducing it into the hole. If cement or other plugs were used, state the character of same and depth placed, from _____ feet to _____ feet for each plug set.

Plugged off bottom of hole with sand. Sand from 3830' to 3740'. Dumped 5 cu ft cement. Mudded hole to 75'. Made 10' of rock bridge. Dumped 4 yards of Redi-mix cement, filling to the bottom of the cellar.

(If additional description is necessary, use BACK of this sheet)

Name of Plugging Contractor Art Lamb Casing Pulling Co.
 Address 2909 King St. Hutchinson, Kansas 67501

STATE OF Kansas COUNTY OF Butte, ss.
Art Lamb (employee of owner) or (owner or operator) of the above-described well, being first duly sworn on oath, says: That I have knowledge of the facts, statements, and matters herein contained and the log of the above-described well as filed and that the same are true and correct. So help me God.

(Signature) [Signature]
2809 King St. Hutchinson, Kansas 67501
 (Address)

Subscribed and sworn to before me this 19th day of July, 1974

My commission expires December 31, 1977

Notary Public.

15-095-01072-0000

Bolinger #2
Owner: Earl F. Wakefield et al
Contractor: Earl F. Wakefield
Comm: 9-19-51 Comp: 10-1-51

NE NE NE 28-28-5 W
Kingman County, Kansas
Casing: 129' of 8 5/8"
3889.29' of 5 1/2"

Elevation 1386

| | |
|------------------------|------|
| Surface | 131 |
| Shale | 660 |
| Shale, Salt & Shells | 880 |
| Lime & Shale | 1025 |
| Shale | 1055 |
| Ft. Riley | 1160 |
| Shale & Lime | 1320 |
| Lime & Shale | 1750 |
| Shale & Sandy Shale | 1933 |
| Lime & Shale | 2230 |
| Lime | 2295 |
| Lime & Shale | 2375 |
| Lime | 2400 |
| Lime & Shale | 2440 |
| Lime | 2455 |
| Sand | 2464 |
| Lime | 2530 |
| Lime & Shale | 2628 |
| Lime | 2710 |
| Sand Lime & Lime Shale | 2862 |
| Shale & Lime | 2981 |
| Lime & Shale | 3260 |
| Lime | 3493 |
| Lime & Shale | 3749 |
| Shale & Lime | 3791 |
| Mississippi Lime | 3804 |
| Chert | 3824 |
| Dolomite | 3830 |
| Total Depth | 3830 |

RECEIVED
STATE CORPORATION COMMISSION
JUN 26 1974
CONSERVATION DIVISION
Wichita, Kansas

3787
1050
- 2405
3804
1386
- 2418

STATE OF KANSAS)
COUNTY OF SEDGWICK) SS

I hereby certify that the above is a true and correct copy of the log on the Bolinger #2 well located NE NE NE 28-28-5, Kingman County, Kansas.

Earl F. Wakefield

Subscribed and sworn to before me this 12th day of October, 1951.

E. James Gaffney

My Commission Expires: 12-23-54