


STATE OF KANSAS
STATE CORPORATION COMMISSION

Give All Information Completely
Make Required Affidavit
Mail or Deliver Report to:
Conservation Division
State Corporation Commission
212 No. Market
Wichita, Kansas

WELL PLUGGING RECORD

NORTH

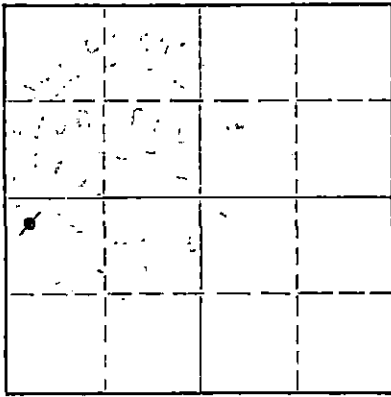

Locate well correctly on above
Section Plat

Kingman County, Sec. 28 Twp. 28 Rge. (E) 5 (W)
Location as "NE/CNWxSWx" or footage from lines NW NW SW
Lease Owner Lario Oil & Gas Company
Lease Name Bolinger "A" Well No. 1
Office Address 301 S. Market, Wichita, Kansas
Character of Well (completed as Oil, Gas or Dry Hole) Oil
Date well completed December 4 1959
Application for plugging filed December 27 1971
Application for plugging approved January 5 1972
Plugging commenced February 15 1972
Plugging completed February 17 1972
Reason for abandonment of well or producing formation Depleted

If a producing well is abandoned, date of last production December 23 1971
Was permission obtained from the Conservation Division or its agents before plugging was commenced? Yes

Name of Conservation Agent who supervised plugging of this well Russell Beberstein
Producing formation Mississippian Depth to top 3881 Bottom 3886 Total Depth of Well PB 3872 Feet
Show depth and thickness of all water, oil and gas formations.

OIL, GAS OR WATER RECORDS

CASING RECORD

FORMATION	CONTENT	FROM	TO	SIZE	PUT IN	PULLED OUT
				8 5/8"	257.62	
				5 1/2"	3965	3249.65

Describe in detail the manner in which the well was plugged, indicating where the mud fluid was placed and the method or methods used in introducing it into the hole. If cement or other plugs were used, state the character of same and depth placed, from _____ feet to _____ feet for each plug set.

Filled with sand from 3872' to 3860'. Run 5 sacks of cement from 3860' to 3830'. Set plug at 260'. Rock from 260' to 250'. Run 4 yards ready mix cement from 250' to base of cellar.

RECEIVED
STATE CORPORATION COMMISSION
FEB 25 1972
CONSERVATION DIVISION
Wichita, Kansas
2-25-72


(If additional description is necessary, use BACK of this sheet)

Name of Plugging Contractor Glenn & Smith Pipe Pulling Co.
Address Box 156, Ellinwood, Kansas 67526

STATE OF Kansas, COUNTY OF Sedgwick, ss.
G. R. Kelsey (employee of owner) or (owner or operator) of the above-described well, being first duly sworn on oath, says: That I have knowledge of the facts, statements, and matters herein contained and the log of the above-described well as filed and that the same are true and correct. So help me God.

(Signature) G. R. Kelsey, Div. Prod. Supt.
301 South Market, Wichita, Kansas 67202
(Address)

Subscribed and sworn to before me this 24th day of February, 1972

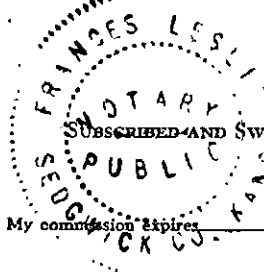

Frances Leslie
Notary Public.

15-095-01073-0000

LARIO OIL & GAS COMPANY
Bolinger "A" No. 1
NW NW SW Sec. 28-28S-5W
Kingman County, Kansas

RECEIVED
STATE CORPORATION COMMISSION
DEC 28 1971
CONSERVATION DIVISION
Wichita, Kansas

Drilling Commenced: November 21, 1959
Drilling Completed: December 1, 1959
Well Completed: December 4, 1959
Drilling Contractor: Prime Drilling Company
Total Depth: 3925'
I.P. - State Potential 20.04 oil plus 60% water

Casing Record:

8 5/8" 257.62 Set @ 268'
Cem. w/ 225 sacks
5 1/2" 3965' Set @ 3924'
Cem. w/ 100 sacks & 30 gal.
latex

Formation	Depth
Surface clay and rock	15
Sand & shale	100
Sandy shale & shale	292
Shale & shells	725
Anhydrite	755
Lime & shale	2440
Lime	2775
Lime, shale & sand	2960
Shale	3092
Lime	3220
Lime & shale	3310
Lime	3499
Lime & shale	3570
Lime	3690
Lime & shale	3860
Mississippi Chat	3870
Core (Miss. Chat)	3899
Lime & chert	3925

GEOLOGICAL TOPS - K.B. MEAS.

Elevation	1416 K.B.
Heebner Shale	2754 (-1338)
Base Oread	2786 (-1370)
Iatan Limestone	2994 (-1578)
Lansing	3094 (-1678)
Base Kansas City	3500 (-2084)
Marmaton	3542 (-2126)
Cherokec	3680 (-2264)
Mississippian	3861 (-2445)
Rotary T.D.	3925 (-2509)
Schlumberger T.D.	3924 (-2508)

12-3-59 Welex perforated 20/3881-3886
12-4-59 Halliburton acidized w/ 500 gallons MCA
5-29-64 P.B. 3872