

15-155-20067-0000

STATE OF KANSAS  
STATE CORPORATION COMMISSION

Form CP-4


Give All Information/Make Required Affidavit/ Mail or Deliver Report to:  
Conservation Division  
State Corporation Commission  
212 No. Market  
Wichita, Kansas

WELL PLUGGING RECORD

Reno County, Sec. 33 Twp. 23S Rge. 4 XXXX (W)

Location as "NE/CNW/SW" or footage from lines SE SW SE  
Lease Owner Charles D. Johnson  
Lease Name Goeringf Well No. 1  
Office Address Box # 231, McPherson, Kansas - 67460  
Character of Well (completed as Oil, Gas or Dry Hole) Dry  
Date well completed July 3, 19 68  
Application for plugging filed 19  
Application for plugging approved 19  
Plugging commenced 19  
Plugging completed July 3, 19 68  
Reason for abandonment of well or producing formation Hole dry

NORTH

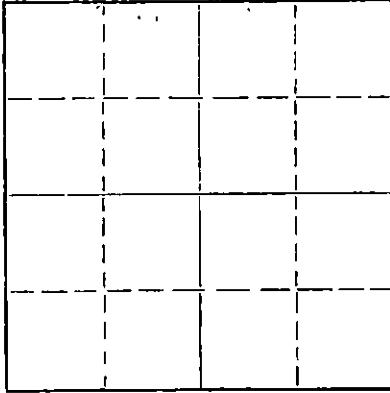

Locate well correctly on above Section Plat

If a producing well is abandoned, date of last production 19  
Was permission obtained from the Conservation Division or its agents before plugging was commenced? Yes

Name of Conservation Agent who supervised plugging of this well Gilbert Toman  
Producing formation Depth to top Bottom Total Depth of Well Feet  
Show depth and thickness of all water, oil and gas formations.

OIL, GAS OR WATER RECORDS

CASING RECORD

FORMATION	CONTENT	FROM	TO	SIZE	PUT IN	PULLED OUT
Sand		0	215	13"	215'	None
Shale		215	257	13"	42'	None

Describe in detail the manner in which the well was plugged, indicating where the mud fluid was placed and the method or methods used in introducing it into the hole. If cement or other plugs were used, state the character of same and depth placed, from feet to feet for each plug set.

Filled hole with mud to 250 ft. Set plug and 1/2 sack julls put in 35 sacks cement. Filled with mud to 30' and set plug, and 1/2 sack hulls and put in 15 sacks cement. 2 sacks in rathole. Plugging completed at 10:00 A.M., July 3, 1968 by Gilbert J. Toman, State Plugger

RECEIVED  
STATE CORPORATION COMMISSION  
JUL 8 1968  
CONSERVATION DIVISION  
Wichita, Kansas


(If additional description is necessary, use BACK of this sheet)

Name of Plugging Contractor BLACKSTONE DRILLING, INC.  
Address Box # 455, McPherson, Kansas - 67460

STATE OF KANSAS, COUNTY OF MC PHERSON, ss.  
Charles D. Johnson (operator) of the above-described well, being first duly sworn on oath, says: That I have knowledge of the facts, statements, and matters herein contained and the log of the above-described well as filed and that the same are true and correct. So help me God.

(Signature) [Signature]  
Box # 231, McPherson, Kansas - 67460 (Address)

Subscribed and sworn to before me this 3rd day of July, 19 68  
My commission expires May 27, 1972  
Juanita M. Flood Notary Public

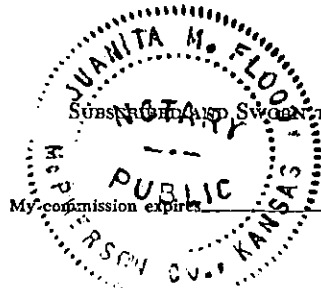

**Blackstone Drilling, Inc.**

Box 455 • 523 West Kansas • Phone CH. 1-1250

McPHERSON • KANSAS  
67460

July 3, 1968

15-155-20062-0000

COMPANY: CHARLES D. JOHNSON  
 CONTRACTOR: BLACKSTONE DRILLING, INC.  
 TOWER: COERING # 1  
 LOCATION: SE SW SE, Sec. 33-235-4W,  
 Reno County, Kansas  
 COMMENCED: June 26, 1968  
 COMPLETED: July 3, 1968  
 ELEVATION:

RECEIVED  
 STATE CORPORATION COMMISSION  
 JUL 8 1968  
 CONSERVATION DIVISION  
 Wichita, Kansas

0	to	215	Sand
215	to	257	Shale
257	to	500	Shale & Lime
500	to	835	Lime & Shale
835	to	1125	Lime
1125	to	1708	Lime & Shale
1708	to	2110	Shale & Lime
2110	to	2597	Lime & Shale
2597	to	2628	Brown Lime
2628	to	3030	Kansas City
3030	to	3327	Lime & Shale
3327	to	3385	Mississippi
		3385	T. D.

Cut 17 1/4 in. hole to 257 ft. and run 259.65 ft. of 13 in. surface pipe, cemented with 250 sacks cement on bottom at 257 ft. Plug down at 2:30 P.M., June 26, 1968. Cut 7 7/8 in. hole to 3385 ft. Hole dry and abandoned. Filled hole with mud to 250'. Set plug and 1/2 sack hulls, put in 35 sacks cement. Filled with mud to 30 ft., set plug and 1/2 sack hulls and put in 15 sacks cement. Two sacks in rat-hole. Plugging job completed at 10:00 A.M., July 3, 1968 by Gilbert Towan, State Plugger.

TOPS: Brown Line - 2597 ft. Lansing - 2628' Mississippi - 3327'

Measurements taken from K.B.

**CERTIFICATE**

I, H. J. Plouffe, President of Blackstone Drilling, Inc. do hereby certify that the above and foregoing is a true and correct copy of log on your Coering #1, located on the SE SW Se of Sec. 33-235-4W, Reno County, Kansas as reflected by the files of Blackstone Drilling, Inc.

*H. J. Plouffe*  
 H. J. Plouffe, President

Subscribed and sworn to before me a Notary Public in and for McPherson County, Kansas this 5th day of July, 1968.

*Ruth McVay*  
 Ruth McVay - Notary Public

