

STATE OF KANSAS
STATE CORPORATION COMMISSION


WELL PLUGGING RECORD

15-155-20470-0000

Give All Information Completely
Make Required Affidavit
Mail or Deliver Report to
Conservation Division
State Corporation Comm.
245 North Water
Wichita, KS 67202

RENO County. Sec. 33 Twp. 23 Rge. 4W W/W
Location as "NE/CNW $\frac{1}{2}$ /SW $\frac{1}{2}$ " or footage from lines _____

Lease Owner WPCO INC.
Lease Name Pierce Well No. 5
Office Address 2225 EAST 21ST North, Suite 205 Wichita, KS, 67214
Character of Well (Completed as Oil, Gas or Dry Hole) _____

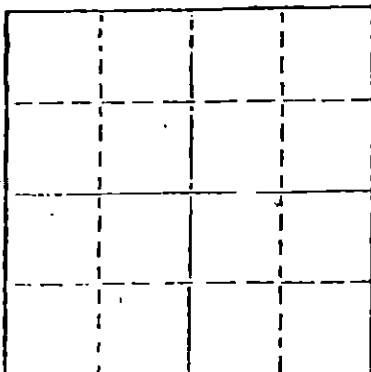

Locate well correctly on above
Section Plot

Date Well completed 11-19 1977
Application for plugging filed _____ 19____
Application for plugging approved 9-27 1979
Plugging commenced 4-4 1979
Plugging completed 4-6 1979
Reason for abandonment of well or producing formation _____

If a producing well is abandoned, date of last production _____ 19____

Was permission obtained from the Conservation Division or its agents before plugging was commenced? yes

Name of Conservation Agent who supervised plugging of this well Gilbert TOMAH
Producing formation _____ Depth to top 3348 Bottom 3355 Total Depth of Well 3355'
Show depth and thickness of all water, oil and gas formations.

OIL, GAS OR WATER RECORDS

CASING RECORD

FORMATION	CONTENT	FROM	TO	SIZE	PUT IN	PULLED OUT
				12 1/4"	200'	- 0 -
				8 5/8"	555'	- 0 -
				5 1/2"	3348	2718.

Describe in detail the manner in which the well was plugged, indicating where the mud fluid was placed and the method or methods used in introducing it into the hold. If cement or other plugs were used, state the character of same and depth placed, from _____ feet to _____ feet for each plug set.

4-4-79 Rigged up Unit. Set bottom plug AT 3330' 10' rock bridge. Dumped 5 sacks cement. Rigged up Floor & Jacks 4-5-79 Ripped pipe at 2718' Pulled part of the casing out. 4-6-79 Finished Laying casing down. Set top plug at 3350' 15' rock bridge. Filled To Top with ready mix. Rigged down.

This is all information furnished us.

(If additional description is necessary, use BACK of this sheet)

Name of Plugging Contractor Towanda Well Service, Inc.


STATE OF KANSAS COUNTY OF Butler, ss.
George Keith (employee of owner) or (owner or operator)
of the above-described well, being first duly sworn on oath, says: That I have knowledge of the facts, statements, and matters herein contained and the log of the above-described well as filed and that the same are true and correct. So help me God.

(Signature) Lewis C. Wilson
608 Main, Towanda, KS, 67144
(Address)

SUBSCRIBED AND SWORN TO before me this 10th day of April, 1979

Barbara D. Simmons
Notary Public.

My commission expires

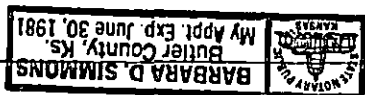

RECEIVED
STATE CORPORATION COMMISSION

APR 12 1979

CONSERVATION DIVISION
Wichita, Kansas

THOMAS R. SATTER
GEOLOGIST

GEOLOGICAL REPORT & LOG

MDIC

5 PIERCE

LOC. NE SE NE SEC. 33 TWNSP 23 SRNG. 4 W
RENO COUNTY, KANSAS

CONTRACTOR SMITHERMAN DRLG. CO.

COMMENCED 11-12-77

COMPLETED 11-19-77

ELEVATION: 1481' KB
1478' DF
1476' GL

CASING RECORD:
8 5/8" - 555' - 400 SX
12 1/4" - 200' - 200 SX
5 1/2" - 3348'

FORMATION TOPS

<u>NAME</u>	<u>DEPTH</u>	<u>DATUM</u>
<u>BROWN LIME</u>	<u>2562</u>	<u>- 1081</u>
<u>KANSAS CITY</u>	<u>2783</u>	<u>- 1302</u>
<u>B/KC</u>	<u>3031</u>	<u>- 1550</u>
<u>CHEROKEE</u>	<u>3193</u>	<u>- 1712</u>
<u>MISSISSIPPI</u>	<u>3319</u>	<u>- 1838</u>
<u>ROTARY TOTAL DEPTH</u>	<u>3355</u>	<u>- 1874</u>

RECEIVED
STATE CORPORATION COMMISSION

MAR 27 1979

CORES: NONE

CONSERVATION DIVISION
Wichita, Kansas

DRILL STEM TESTS: NONE

ELECTRICAL SURVEYS: NONE