

15095-00221000


STATE OF KANSAS  
STATE CORPORATION COMMISSION

Give All Information Completely  
Make Required Affidavit  
Mail or Deliver Report to:  
Conservation Division  
State Corporation Commission  
800 Bitling Building  
Wichita, Kansas

WELL PLUGGING RECORD

Kingman County. Sec. 29 Twp. 28 Rge. (E) 5 (W)  
Location as "NE/CNW $\frac{1}{4}$ SW $\frac{1}{4}$ " or footage from lines NE NE NE  
Lease Owner Westgate-Greenland Oil Company  
Lease Name Beck Well No. 1  
Office Address 1022 Union National Bank Building, Wichita 2, Kansas  
Character of Well (completed as Oil, Gas or Dry Hole) dry hole  
Date well completed September 17, 1950 19  
Application for plugging filed October 19, 1950 19  
Application for plugging approved October 19, 1950 19  
Plugging commenced November 1, 1950 19  
Plugging completed November 4, 1950 19  
Reason for abandonment of well or producing formation

NORTH

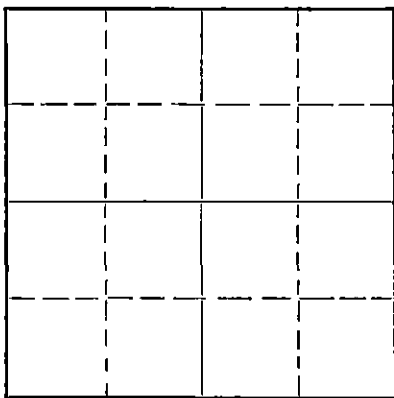

Locate well correctly on above  
Section Flat

If a producing well is abandoned, date of last production 19  
Was permission obtained from the Conservation Division or its agents before plugging was commenced? yes

Name of Conservation Agent who supervised plugging of this well Ruel Durkee  
Producing formation Depth to top Bottom Total Depth of Well Feet  
Show depth and thickness of all water, oil and gas formations.

OIL, GAS OR WATER RECORDS

CASING RECORD

Formation	Content	From	To	Size	Put In	Pulled Out
Surface		0	199	8 5/8"	199	none
Mississippi		0	3884	5 1/2"	3884	3250.75'

Describe in detail the manner in which the well was plugged, indicating where the mud fluid was placed and the method or methods used in introducing it into the hole. If cement or other plugs were used, state the character of same and depth placed, from feet to feet for each plug set.

Plugged back from 3908 to 3860 feet with rock  
Ran 6 sacks cement from 3860 to 3820 feet  
Filled hole with heavy mud from 3820 to 200 feet  
Made hole solid with rock from 200 feet to 190 feet  
Ran 15 sacks cement from 190 to 150 feet  
Filled hole with heavy mud from 150 to 30 feet  
Capped with 9 sacks of cement from 30 feet to cellar.

RECEIVED  
STATE CORPORATION COMMISSION  
NOV 14 1950  
CONSERVATION DIVISION  
WICHITA, KANSAS

Correspondence regarding this well should be addressed to Westgate-Greenland Oil Company  
Address 1022 Union National Bank Building, Wichita 2, Kansas

STATE OF Kansas, COUNTY OF Sedgwick, ss.  
G. E. Bitler (employee of owner) or (owner or operator) of the above-described well,  
being first duly sworn on oath, says: That I have knowledge of the facts, statements, and matters herein contained and the log of the above-described well as filed and that the same are true and correct. So help me God.

(Signature) G. E. Bitler  
1022 Union National Bank Bldg, Wichita 2, Kans  
(Address)

SUBSCRIBED AND SWORN TO before me this 13th day of November, 1950.

Ether Russell  
Notary Public.

My commission expires May 25, 1953

23-3273-s 4-50-10M  
PLUGGED  
FILE SEC 29 T 28 R 32  
BOOK PAGE 56 LINE 27

15095002210000

COMPANY: Westgate Greenland Oil Co.  
 CONTRACTOR: Jackson Drilling Corporation  
 FARM: Beck #1  
 LOCATION: NE NE NE Section 29-28-5W  
 Kingman County, Kansas  
 ELEVATION: 1417.  
 COMMENCED: August 29, 1950  
 COMPLETED: September 11, 1950 Rotary  
 September 17, 1950 Cardwell

0	to	490	Shale & shells
490	to	695	Shale & salt
695	to	845	Shale - lime shells
845	to	880	Anhydrite
880	to	960	Shale - lime streaks
960	to	1745	Lime & shale
1745	to	2010	Shale - lime shells
2010	to	3045	Lime & shale
3045	to	3125	Lime
3125	to	3185	Lime & shale
3185	to	3280	Lime
3280	to	3330	Lime & broken lime
3330	to	3379	Lime
3379	to	3438	Lime & broken lime
3438	to	3480	Lime
3480	to	3839	Shale & lime
3839	to	3884	Mississippi
		3884	T.D. Rotary
		3908	Cardwell

8 5/8" - 24# casing set at 199 feet. Cemented with 135 sacks cement and 2 sacks calcium chloride.

5 1/2" casing set at 3884 feet. Cemented with 75 sacks cement.

Drill stem test at 3330, open 1 hour, recovered 155 feet of oil and gas cut muddy water.

Drill stem test at 3871, open 1 hour, recovered 30 feet drilling mud.

Lane Wells perforated 70 holes from 3883 to 3862.

Dowell Service - 1000 gallons - show oil and water,  
2000 gallons - swabbed 4 barrels oil and 500 barrels water in 13 hours.

Dry

**RECEIVED**  
 STATE CORPORATION COMMISSION  
 OCT 19 1950  
 CONSERVATION DIVISION  
 Wichita, Kansas

C E R T I F I C A T E

I, Clare A. Stewart, do hereby certify that the above and foregoing is a true and correct copy of the log of the Beck #1, Section 29-28-5W, Kingman County, Kansas, as reflected by files of the Jackson Drilling Corporation.

**PLUGGING**  
 FILE SEC 29 T 28 R 5W  
 BOOK PAGE 31 LINE 27

*Clare A. Stewart*  
 Clare A. Stewart

Subscribed and sworn to before me, a Notary Public, within and for Johnson County, Kansas, this 11th day of October, 1950.

*Dorothy J. Wilson*  
 Dorothy J. Wilson

My Commission expires November 30, 1950.