


15-095-00277000

STATE OF KANSAS  
STATE CORPORATION COMMISSION  
Give All Information Completely  
Make Required Affidavit  
Mail or Deliver Report to:  
Conservation Division  
State Corporation Commission  
211 No. Broadway  
Wichita, Kansas

### WELL PLUGGING RECORD

KINGMAN County. Sec. 29 Twp. 28 Rge. 5 (E) W (W)  
Location as "NE/CNW/SW" or footage from lines SE NE NW  
Lease Owner PETROLEUM, INC.  
Lease Name BOLINGER "B" Well No. 2  
Office Address ROUTE 2, GREAT BEND, KANSAS  
Character of Well (completed as Oil, Gas or Dry Hole) DRY HOLE  
Date well completed December 16, 19 57  
Application for plugging filed December 18; 19 57  
Application for plugging approved December 18, 19 57  
Plugging commenced December 16; 19 57  
Plugging completed December 17, 19 57  
Reason for abandonment of well or producing formation  
No Produccible Zones  
If a producing well is abandoned, date of last production None 19      
Was permission obtained from the Conservation Division or its agents before plugging was commenced? Yes

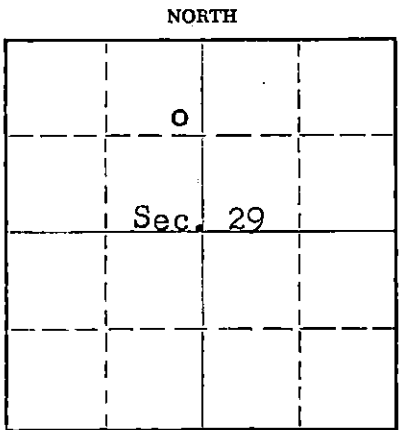

Locate well correctly on above Section Plat

Name of Conservation Agent who supervised plugging of this well M.A. Rives, Box 8, Pratt, Kansas  
Producing formation                      Depth to top      Bottom      Total Depth of Well 3988 Feet  
Show depth and thickness of all water, oil and gas formations.

#### OIL, GAS OR WATER RECORDS

#### CASING RECORD

FORMATION	CONTENT	FROM	TO	SIZE	PUT IN	PULLED OUT
				8-5/8"	256'	None

Describe in detail the manner in which the well was plugged, indicating where the mud fluid was placed and the method or methods used in introducing it into the hole. If cement or other plugs were used, state the character of same and depth placed, from                      feet to                      feet for each plug set.

Mud up with heavy mud to 250', pushed down 1/3 sack hulls to 250' followed by wooden plug. Placed 20 sacks cement through drill pipe on to plug. Mud up to 35' and placed 1/3 sack hulls at 35' followed by wooden plug and 10 sacks cement to base of well cellar.

RECEIVED  
STATE CORPORATION COMMISSION

DEC 27 1957  
10-27-57  
CONSERVATION DIVISION  
Wichita, Kansas

(If additional description is necessary, use BACK of this sheet)  
Name of Plugging Contractor GARVEY DRILLING COMPANY  
Address ROUTE 2, GREAT BEND, KANSAS

STATE OF KANSAS, COUNTY OF BARTON, ss.  
Don Searle (employee of owner) or (owner or operator) of the above-described well, being first duly sworn on oath, says: That I have knowledge of the facts, statements, and matters herein contained and the log of the above-described well as filed and that the same are true and correct. So help me God.

(Signature) Don Searle  
Route 2, Great Bend, Kansas  
(Address)

SUBSCRIBED AND SWORN to before me this 26th day of December, 19 57

Ed J. Brown  
Notary Public.

My commission expires July 11, 1960

PLUGGING  
FILE SEC 29 T. 28 RS W  
BOOK PAGE 70 LINE 6

# WELL LOG

15-095-00277-0000

COMPANY PETROLEUM, INCORPORATED

SEC. 29 T. 28S R. 5W

FARM BOLINGER "B" NO. 2


LOC. SE, NE, NW

TOTAL DEPTH 3988'

COUNTY KINGMAN CO., KANSAS

COMM. December 5, 1957 COMP. December 17, 1957

CONTRACTOR GARVEY DRILLING COMPANY

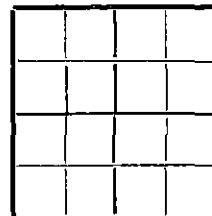

CASING 8 5/8" @ 256' W/200 sax.

ELEVATION 1458' DF

PRODUCTION D & A

FIGURES INDICATE BOTTOM OF FORMATIONS

40	Sand
200	Red bed & shale
260	Shale & lime
830	Shale & shells
1200	Shale & lime
1320	Lime & shale
1500	Lime
2132	Shale & lime
2300	Shale
2790	Shale & lime
2918	Shale, lime & sand
3074	Lime & shale
3160	Lime
3261	Lime & shale
3585	Lime
3896	Lime & shale
3925	Chert
3945	Lime & shale
3988	Lime & chert
3988	T. D.

RECEIVED  
STATE CORPORATION COMMISSION

DEC 27 1957

CONSERVATION DIVISION  
Wichita, Kansas

LOGGING  
FILE SEC 29 T. 28 R. 5W  
BOOK PAGE 70 LINE 6

State of KANSAS }  
County of BARTON } SS:

I, VERNE A. MORRIS of GARVEY DRILLING COMPANY

upon oath state that the above and foregoing is a true and correct copy of the log of the #2 Bolinger "B" well

Verne A. Morris

Subscribed and sworn to before me this 26th day of December 19 57

My Commission Expires: July 11, 1960

Ed J. Brown  
NOTARY PUBLIC