

WELL PLUGGING RECORD

All Information Completely
Required Affidavit
For Deliver Report to:
Conservation Division
State Corporation Commission
211 No. Broadway
Wichita, Kansas

Kingman County. Sec. 15 Twp. 28S Rge. 6 (E) W (W)

Location as "NE/CNW%SW%" or footage from lines. C SE NE

Lease Owner. Donald F. Moore

Lease Name. Fay Well No. 2

Office Address. 918 Central Building, Wichita, Kansas

Character of Well (completed as Oil, Gas or Dry Hole)

Date well completed July 17 19 63

Application for plugging filed July 17 19 63

Application for plugging approved July 17 19 63

Plugging commenced July 17 19 63


Plugging completed 4:30 a.m. July 17 19 63

Reason for abandonment of well or producing formation

Dry Hole

If a producing well is abandoned, date of last production 19

Was permission obtained from the Conservation Division or its agents before plugging was commenced? Yes

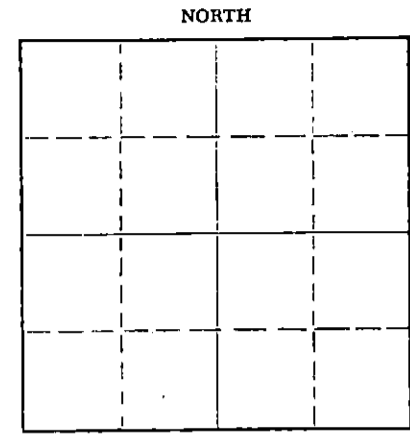

Locate well correctly on above
Section Plat

Name of Conservation Agent who supervised plugging of this well Archie Elzing, Box 248, Pratt, Kansas

Producing formation 2 Depth to top Bottom Total Depth of Well 3900 Feet

Show depth and thickness of all water, oil and gas formations.

OIL, GAS OR WATER RECORDS

CASING RECORD

FORMATION	CONTENT	FROM	TO	SIZE	PUT IN	PULLED OUT

Describe in detail the manner in which the well was plugged, indicating where the mud fluid was placed and the method or methods used in introducing it into the hole. If cement or other plugs were used, state the character of same and depth placed, from feet to feet for each plug set.

Filed hole with heavy rotary mud from Total Depth to 215',
set plug with 1/4 sx cotton seed hulls and 20 sx cement.
Filled hole with heavy mud to 40', set plug with 1/4 sx
cotton seed hulls and 10 sx cement to top of hole. Plugged
rat hole with 2 sx cement.

RECEIVED
STATE CORPORATION COMMISSION
JUL 26 1963
7-26-63
CONSERVATION DIVISION
Wichita, Kansas

(If additional description is necessary, use BACK of this sheet)

Name of Plugging Contractor
Address

STATE OF Kansas, COUNTY OF Sedgwick, ss.

L. J. Clampitt - Agent (XXXXXXXXXX) or (owner or operator) of the above-described well, being first duly sworn on oath, says: That I have knowledge of the facts, statements, and matters herein contained and the log of the above-described well as filed and that the same are true and correct. So help me God.

(Signature) L. J. Clampitt - Agent
814 Union Center, Wichita, Kansas (Address)

SUBSCRIBED AND SWORN TO before me this 24th day of July, 19 63

My commission expires January 17, 1967 Jeannine Herrman Notary Public.

ROTARY DRILLING LOG

OWNER: D. F. Moore, etals
 CONTRACTOR: Prime Drilling Company
 LEASE: Fay #2
 LOCATION: C. SE NE Sec. 15-28S-6W
 Kingman County, Kansas

CASING: Set 8 5/8" surface casing
 @ 217', cemented with 175
 sx HAS com.

0 - 45	Red Rock
45 - 270	Red Bed
270 - 540	Shale & Lime
540 - 815	Shale
815 - 830	Anhydrite
830 - 950	Shale & Lime
950 - 1170	Lime
1170 - 1335	Shale & Lime
1335 - 1705	Lime
1705 - 1825	Lime & Shale
1825 - 2139	Shale
2139 - 2601	Lime
2601 - 2770	Lime & Shale
2770 - 3090	Shale & Lime
3090 - 3645	Lime
3645 - 3680	Shale & Lime
3680 - 3766	Lime
3766 - 3859	Lime & Shale
3859 - 3900	Mississippi Lime
3900	Rotary Total Depth

D & A

RECEIVED
 STATE CORPORATION COMMISSION

JUL 26 1963

CONSERVATION DIVISION
 Wichita, Kansas

We certify that the above log is true and correct to the best of our knowledge and belief.

PRIME DRILLING COMPANY

L. C. Clappitt
 L. C. Clappitt