

STATE OF KANSAS
STATE CORPORATION COMMISSION


Give All Information Completely
Make Required Affidavit
Mail or Deliver Report to:
Conservation Division
State Corporation Commission
212 No. Market
Wichita, Kansas

15-155-01665-0000

Form CP-4

WELL PLUGGING RECORD

NORTH

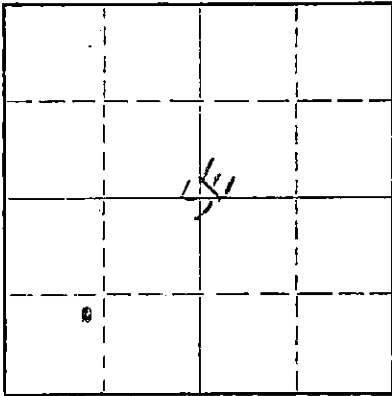

Locate well correctly on above
Section Plat

Reno County, Sec. 25 Twp. 23S Rge. 4 (E) W (W)
Location as "NE/CNW/SW" or footage from lines C-SW-SE
Lease Owner S. & K. Oil Co.
Lease Name Fast Well No. 7
Office Address Tulsa, Oklahoma
Character of Well (completed as Oil, Gas or Dry Hole) Oil
Date well completed 9-20-63 19
Application for plugging filed Oct 9th 1968 19
Application for plugging approved Oct 10, 1968 19
Plugging commenced Oct. 21 19
Plugging completed Oct. 23 1968
Reason for abandonment of well or producing formation Depleted

If a producing well is abandoned, date of last production ? 19
Was permission obtained from the Conservation Division or its agents before plugging was commenced? Yes

Name of Conservation Agent who supervised plugging of this well Gilbert Toman
Producing formation Miss Depth to top Bottom Total Depth of Well 3376 Feet
Show depth and thickness of all water, oil and gas formations.

OIL, GAS OR WATER RECORDS

CASING RECORD

FORMATION	CONTENT	FROM	TO	SIZE	PUT IN	PULLED OUT
				10 3/4	275	
				5 1/2	3308	2437.14
Mississippi			3262			

Describe in detail the manner in which the well was plugged, indicating where the mud fluid was placed and the method or methods used in introducing it into the hole. If cement or other plugs were used, state the character of same and depth placed, from feet to feet for each plug set.

Set bridge at 3275' and dumped 5 sacks of cement.

Shot pipe off at 2437.14'. Pulled pipe and mudded hole to 265'. Set 10' rock bridge and finished filling hole with ready-mix-cement.

RECEIVED
STATE CORPORATION COMMISSION
DEC 23 1968
CONSERVATION DIVISION
Wichita, Kansas

Name of Plugging Contractor Bert Self
Address Hutchinson, Kans.

STATE OF Kans. COUNTY OF Reno, ss.
Employee (employee of owner) or (owner or operator) of the above-described well, being first duly sworn on oath, says: That I have knowledge of the facts, statements, and matters herein contained and the log of the above-described well as filed and that the same are true and correct. So help me God.

(Signature) Bert Self
R. R. #4, Hutchinson, Kans.
(Address)

Subscribed and sworn to before me this 15th day of Nov. 19 68
October 18, 1969



Notary Public.

S & K OIL CO.
P. O. BOX 682 TULSA, OKLA.
ZIP 74101

15-155-01665-0000

SUPPLEMENTAL COMPLETION REPORT

Company: S & K Oil Co.
Farm & Well: East No. 7
Location: C SW SE Sec. E5-138-4W
Rego County, Kansas

Commenced: 8-9-63 Elev.: 1468' KB
Completed: 9-20-63 Rotary TD 3322'
I.P.: 15 BO & 5 BPPD CT TD 3376'

Casing Record:
10 3/4" @ 275' W/275 Saz Cement
5 1/2" @ 3308' W/150 Saz Cement

FORMATION TOU:

Heebner 2342'
Lensing 2533'
Kansas City Base 2981'
Cherokee 3150'
Mississippi 3262'
Rotary TD 3322'
Cable Tool TD 3376'

LOG:

0	200	Sand
200	275	Shale
275	440	Shale and Shells
440	2670	Shale and Lime
2670	2845	Lime
2845	2960	Lime and Shale
2960	3045	Lime
3045	3260	Shale and Lime
3260	3305	Lime, Shale and Chert
3305	3322	Lime
3322	3376	Lime

Electric Log: Welox: Gamma Ray-Neutron

DST: None

Cores: None

STATE OF OKLAHOMA)

COUNTY OF TULSA)

I, Louis Kahan, Operator, being first duly sworn under oath, say: That I have knowledge of the facts, statements, and matters herein contained of the above described well as filed and that the same are true and correct.

Louis Kahan
LOUIS KAHAN

Subscribed and sworn to before me this 16th day of January, 1964.

R. Williams
NOTARY PUBLIC

My commission expires: May 20, 1966

RECEIVED
STATE CORPORATION COMMISSION
OCT 10 1968
CONSERVATION DIVISION
Wichita, Kansas