

15-155-0166-0000


STATE OF KANSAS
STATE CORPORATION COMMISSION

Form CP-4

Give All Information Completely
Make Required Affidavit
Mail or Deliver Report to:
Conservation Division
State Corporation Commission

WELL PLUGGING RECORD

P. O. Box 17027
Wichita, Kansas 67217
NORTH

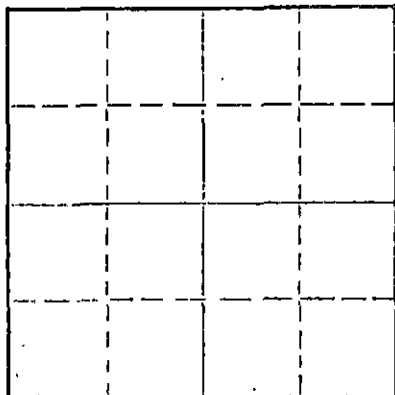

Locate well correctly on above
Section Plat

Reno County, Sec. 25 Twp. 23 Rge. 4 (E) (W)
Location as "NE/CNW/SW" or footage from lines C SE SE

Lease Owner S. & K. Oil Company

Lease Name Fast Well No. 8

Office Address P.O. Box 559 Tulsa, Oklahoma 74101

Character of Well (completed as Oil, Gas or Dry Hole) oil

Date well completed IO-6 1963

Application for plugging filed IO-II 1973

Application for plugging approved IO-I2 1973

Plugging commenced IO-I6 1973

Plugging completed IO-I8 1973

Reason for abandonment of well or producing formation

If a producing well is abandoned, date of last production 19

Was permission obtained from the Conservation Division or its agents before plugging was commenced? Yes - Hugh Scott

Name of Conservation Agent who supervised plugging of this well Hugh Scott

Producing formation Depth to top Bottom Total Depth of Well 3374' Feet

Show depth and thickness of all water, oil and gas formations.

OIL, GAS OR WATER RECORDS

CASING RECORD

FORMATION	CONTENT	FROM	TO	SIZE	PUT IN	PULLED OUT
				5 1/2"		2,242'
				8"		407'
RECEIVED STATE CORPORATION COMMISSION OCT 23 1973 CONSERVATION DIVISION Wichita, Kansas						

Describe in detail the manner in which the well was plugged, indicating where the mud fluid was placed and the method or methods used in introducing it into the hole. If cement or other plugs were used, state the character of same and depth placed, from feet to feet for each plug set.

Plugged off bottom of hole with sand. Sand from 3374' to 3250'. Dumped 5 sx of cement. Mudded hole to 470'. Made 10' of rock bridge. Dumped 3 sx of cement. Mudded hole to 280'. Made 10' of rock bridge. Dumped 6 Yrds. of Ready-Mix cement, filling to the bottom of the cellar.

(If additional description is necessary, use BACK of this sheet)

Name of Plugging Contractor Art Lamb Casing Pulling Co.

Address 2809 King St. Hutchinson, Kansas 67501

STATE OF Kansas, COUNTY OF Reno, ss.

Art Lamb (employee of owner) or (owner or operator) of the above-described well, being first duly sworn on oath, says: That I have knowledge of the facts, statements, and matters herein contained and the log of the above-described well as filed and that the same are true and correct. So help me God.

(Signature) Art Lamb

2809 King St. Hutchinson, Kansas 67501
(Address)

SUBSCRIBED AND SWORN to before me this 18th day of October 1973

Judy Lamb
Notary Public.

My commission expires January 5, 1974

RECEIVED
031
S & K OIL CO.
K & P OIL CO.
LOUIS KAHAN, ET. AL

15-155-61666-0000

COMPANY: S & K Oil Co.
FARM: Fast #8
LOCATION: C SE SE Sec 25-23-4 - Reno County, Kansas
ROTARY DRILLING CONTRACTOR: Sholom Drilling Company, Inc.

COMMENCED: 9/24/63
COMPLETED: 10/6/63 Rotary T. D.
I.P.:

Elevation: 1462' KB
Rotary TD: 3303'

Casing Record:
10 3/4" @ 262' w/275 sax
8 5/8" @ 514' w/100 sax
5 1/2" @ 3290' w/150 sax

LOG

0 - 170 Clay and Sand
170 - 380 Shale
380 - 515 Shale, lime, cement
550 - 2100 Lime
2100 - 2800 Lime & Shale
2800 - 2955 Lime
2955 - 3040 Lime & Shale
3040 - 3303 Lime

No tests
Welox log at T. D.
Mississippi 3260'

RECEIVED
STATE CORPORATION COMMISSION

SEP 13 1973

CONSERVATION DIVISION
Wichita, Kansas

STATE OF FLORIDA)
COUNTY OF DADE) ss.

I, Joseph Telchman, President of Sholom Drilling Company, Inc. a corporation of the State of Oklahoma, domesticated in the State of Kansas, being first duly sworn under oath, says: That I have knowledge of the facts, statements, and matters herein contained of the above described well as filed and that the same are true and correct.

Joseph Telchman
Joseph Telchman

Subscribed and sworn to before me this 31th day of October,

1963.

J. J. Man
Notary Public

My commission expires: NOTARY PUBLIC STATE of FLORIDA at LARGE
MY COMMISSION EXPIRES JUNE 3, 1968
BONDED THROUGH FRED W. DIESTELHORST

RECEIVED
STATE CORPORATION COMMISSION

SEP 21 1973

CONSERVATION DIVISION
Wichita, Kansas

S & K OIL CO.
P. O. BOX 682 TULSA, OKLAHOMA
ZIP 74101

15-155-01666-0000

SUPPLEMENTAL COMPLETION REPORT

Company: S & K Oil Co.
Farm & Well: East No. 8
Location: SE SE Sec. 25-235-14W
Reno County, Kansas

Commenced: 9-24-63 Elev.: 1462' KB
Completed: 10-20-63 Rotary TD 3303'
I.P.: 12 BOFD Cable TD 3374'

Casing Record:
10 3/4" @ 262' W/275 Saz Cement
8 5/8" @ 514' W/100 Saz Cement
5 1/2" @ 3290' W/150 Saz Cement

FORMATION TOPS:

Hesbner 2332'
Lansing 2519'
B/Kansas City 2984'
Cherokee 3146'
Mississippi 3260'
Rotary TD 3303'
Cable Tool TD 3368'

RECEIVED
STATE CORPORATION COMMISSION

SEP 13 1973

CONSERVATION DIVISION
Wichita, Kansas

LOG:

0	170	Clay and Sand
170	360	Shale
360	515	Shale, lime, cement
550	2100	Lime
2100	2800	Lime & Shale
2800	2955	Lime
2955	3040	Lime & Shale
3040	3303	Lime
3303	3307	Medium, tan sacrosic cherty dolomitic limestone.
3307	3311	Hard, tan sacrosic cherty dolomitic limestone.
3311	3313	Hard, tan sacrosic cherty dolomitic limestone.
3313	3318	Soft, tan medium crystalline dolomitic limestone.
3318	3323	Medium, cream dense very cherty limestone.
3323	3326	Hard
3326	3331	Soft limestone
3331	3340	Hard limestone
3340	3345	Grey Shale
3345	3358	Medium hard white limestone
3358	3368	Soft white limestone
3368	3374	Gray, cherty dense limestone

Electric Log: Welox: Gamma-Ray-Natron

DST: None

Cores: None

Continued on Page 2

RECEIVED
STATE CORPORATION COMMISSION

SEP 21 1973

CONSERVATION DIVISION
Wichita, Kansas

15-155-01666-0000

STATE OF OKLAHOMA)
) ss
COUNTY OF TULSA)

I, Louis Kahan, operator, being first duly sworn under oath, say: That I have knowledge of the facts, statements, and matters herein contained of the above described well as filed and that the same are true and correct.

LOUIS KAHAN

Subscribed and sworn to before me this day of January, 1964.

NOTARY PUBLIC

My commission expires: May 20, 1966

RECEIVED
STATE CORPORATION COMMISSION

SEP 13 1973

CONSERVATION DIVISION
Wichita, Kansas

RECEIVED
STATE CORPORATION COMMISSION

SEP 21 1973

CONSERVATION DIVISION
Wichita, Kansas