

STATE OF KANSAS
STATE CORPORATION COMMISSION

WELL PLUGGING RECORD


OR

FORMATION PLUGGING RECORD

Strike out upper line
when reporting plug-
ging off formations.

Give All Information Completely
Make Required Affidavit
Mail or Deliver Report to:
Conservation Division
State Corporation Commission
800 Bitting Building
Wichita, Kansas

NORTH

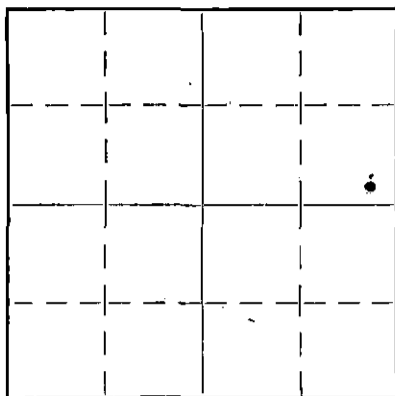

Locate well correctly on above
Section Plat

Reno County. Sec. 25 Twp. 23S Rge. 4 (E) 4 (W)
Location as "NE1/4NW1/4SW1/4" or footage from lines 330' from East line, 330' SL.
Lease Owner OLSON OIL COMPANY
Lease Name J. Fast Well No. 6
Office Address Box 408, Burrton, Kansas
Character of Well (Completed as Oil, Gas or Dry Hole) Dry
Date, well completed 8-11- 1937
Application for plugging filed 8-11- 1937
Application for plugging approved 193
Plugging Commenced 10-4- 1937
Plugging Completed 10-9- 1937
Reason for abandonment of well or producing formation Dry
If a producing well is abandoned, date of last production 193
Was permission obtained from the Conservation Division or its agents before plugging was commenced? Yes

Name of Conservation Agent who supervised plugging of this well Guy Wiershung
Producing formation Chat Depth to top 3269 Bottom 3392 Total Depth of Well 3392 Feet.

Show depth and thickness of all water, oil and gas formations.


OIL, GAS OR WATER RECORDS

CASING RECORD

Formation	Content	From	To	Size	Put In	Pulled Out
Chat	water	3269	3392	12 1/2" OD	356'	
				7" OD	3284'	2880' - 3"

Describe in detail the manner in which the well was plugged, indicating where the mud fluid was placed and the method or methods used in introducing it into the hole. If cement or other plugs were used, state the character of same and depth placed, from feet to feet for each plug set.

Cemented from 3392 back to 3284. Filled with mud to 2700'. Wood plug rock bridge. 15' of cement at 300'. Filled to 22' with mud. 10' of cement.

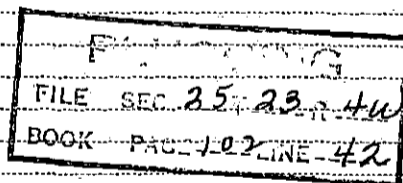

(If additional description is necessary, use BACK of this sheet)

Correspondence regarding this well should be addressed to Olson Oil Company
Address Box 408, Burrton, Kansas

STATE OF Kansas, COUNTY OF Reno, ss.

C. L. Barrett (employee of owner) or (owner or operator) of the above-described well, being first duly sworn on oath, says: That I have knowledge of the facts, statements, and matters herein contained and the log of the above-described well as filed and that the same are true and correct. So help me God.

(Signature) C. L. Barrett

Box 408 Burrton Kansas (Address)

SUBSCRIBED AND SWORN TO before me this 19 day of October, 1937.

My commission expires 11/20/38.

J. I. Bryant Notary Public.

OLSON OIL COMPANY
J. FAST # 6
SE SE NE Sec. 25-23-4W,
Reno County, Kansas

0
318 Sand
456 Shale & shs
96 Shells
538 Anhy'
710 Shale & shs
65 Lime
995 Broken lime
1030 Lime
1132 Shale & shs
1260 Broken lime
1565 Shale & shs
1654 Shale, broken lime
96 Broken lime
1970 Shale & shs
2032 Broken lime
2116 Shale & shs
2235 Broken lime
2334 Shale & shs
2420 Broken lime
69 Shale & lime
2633 Broken lime
45 Lime
70 Lime & shale
2708 Broken lime
2916 Lime
23 Lime, soft
80 Lime
3002 Broken lime
35 Lime
55 Broken lime
88 Lime & shale
3105 Broken lime
3265 Shale, var
69 Shale, var
3392 Chat, TD

15-155-626 36-0000
COMMENCED 7-18-37
COMPLETED 8-11-37
ELEVATION 1461
INT PROD Dry

CASING RECORD

13" OD 40# 356'

7" OD 24# 3284'

SAND RECORD

Show of oil & gas 3349-57
3365 - 2 bailers water per hr.
Show oil

3382 - 6 bailers water per hr.

3392 - 500' fluid in 4 hrs. 90 %
H₂O.

Top Chat 3269

Plugged - 10- 9-37.

I hereby certify that the
above is a true and correct copy of
the log of J. Fast #6, SE SE NE,
Sec. 25-23S-4W, Reno County, Kansas.

C. L. Barrett

Subscribed and sworn to before me
this 19th day of October, 1937.

A. J. Bryant
Notary Public
My commission expires 4/20/38

PLUGGING
FILE SEC. 25-23-4W
BOOK PAGE 102 LINE 42