

15-155-02639-0000

# WELL PLUGGING RECORD

STATE OF KANSAS  
STATE CORPORATION COMMISSION

Give All Information Completely  
Make Required Affidavit  
Mail or Deliver Report to:  
Conservation Division  
State Corporation Commission  
800 Bitting Building  
Wichita, Kansas

OR

## FORMATION PLUGGING RECORD

Strike out upper line  
when reporting plugging  
of formations.

Location as "NE $\frac{1}{4}$ NW $\frac{1}{4}$ SW $\frac{1}{4}$ " or footage from lines. C WL E  $\frac{1}{2}$   
Reno County. Sec. 25 Twp. 23S Rge. 11W 4 (W)

Lease Owner Olson Drilling Co.

Lease Name J. Fast Well No. 4

Office Address P.O. Drawer 2680, Tulsa 1, Oklahoma

Character of Well (completed as Oil, Gas or Dry Hole) Oil

Date well completed 1 - 13 1937

Application for plugging filed 2 - 18 1947

Application for plugging approved 2 - 20 1947


Plugging commenced 3 - 9 1947

Plugging completed 3 - 15 1947

Reason for abandonment of well or producing formation Dry

If a producing well is abandoned, date of last production 9 - 30 1946

Was permission obtained from the Conservation Division or its agents before plugging was commenced? Yes

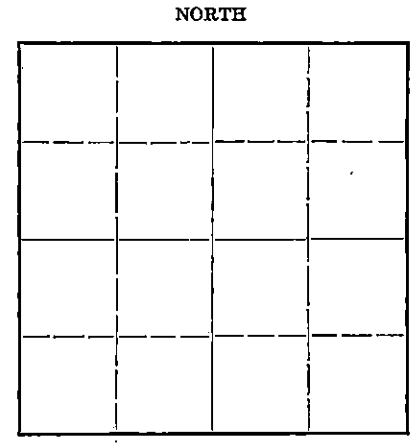

Locate well correctly on above Section Flat

Name of Conservation Agent who supervised plugging of this well Ruel Durkee

Producing formation Chat Depth to top 3269 Bottom 3377 Total Depth of Well 3377 Feet

Show depth and thickness of all water, oil and gas formations.

### OIL, GAS OR WATER RECORDS

### CASING RECORD

Formation	Content	From	To	Size	Put In	Pulled Out
Chat	Oil	3269	3377	13"	260'	None
				7"	3284'	2725'

Describe in detail the manner in which the well was plugged, indicating where the mud fluid was placed and the method or methods used in introducing it into the hole. If cement or other plugs were used, state the character of same and depth placed, from \_\_\_\_\_ feet to \_\_\_\_\_ feet for each plug set.

- 3377' to 3284' Filled hole with mud.
- 3284' ~~to~~ ran wood plug.
- 3284' to 3250' ran 6 sacks of cement.
- 3284' to 260' filled hole with mud.
- 260' to 255' Filled hole with rock.
- 255' to 230' Ran 25 sacks of cement.
- 230' to 15' filled hole with mud.
- 15' to 0' Capped with 8 sacks of cement.

MAR 18 1947

(If additional description is necessary, use BACK of this sheet)

Correspondence regarding this well should be addressed to S.A. Keefover, Olson Drilling Co.  
Address Burrton, Kansas.

STATE OF Kansas COUNTY OF Harvey, ss.


J. L. McManis (employee of owner) or (owner or operator) of the above-described well, being first duly sworn on oath, says: That I have knowledge of the facts, statements, and matters herein contained and the log of the above-described well as filed and that the same are true and correct. So help me God.

(Signature) J. L. McManis  
Burrton, Kansas. (Address)

SUBSCRIBED AND SWORN to before me this 17th day of March, 1947

My commission expires 7-22-48

Notary Public.

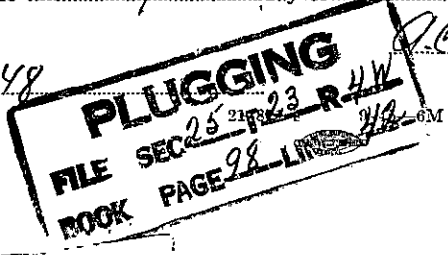

15-155-02639-0000

DLDG.  
OLSON OIL COMPANY  
J. FAST # 4  
C WL E<sub>2</sub> 25 23S 4W  
RENO COUNTY, KANSAS.

COMMENCED 12-15-36  
COMPLETED 1-13-37  
ELEVATION 1463'  
INT prod. 175

CASING RECORD

13" 40# 260'  
7" 24# 3284'

TOP OF CHAT  
3269'

0  
125--Sand  
60--Shells  
216-- " & sand  
65-- " shale  
94-- "  
475-- " "  
570--Broken Lime  
775--Shale & sh.  
805--Lime, hard  
30--Shale & sh.  
70--Broken lime & shale  
910--Shale & lime sh.  
70--Broken lime  
89--Lime  
98--Broken lime  
1065-- " " & shale  
1218--Shale & shells  
58--Shale  
1828-- " "  
72--Broken lime  
76--Lime, hard  
1900--Broken lime  
57--Shale & shells  
2242--Lime  
88--Sandy lime  
2460--Lime  
2510--Shale & shells  
2626--Lime  
2910--Broken lime  
52--Lime, hard  
75--Lime  
85--Shale, dark  
3153--Lime  
93--Shale  
3269--var. shale  
3377--Chat  
T.D.

**PLUGGING**  
FILE SEC 25 T 23 R 4W  
BOOK PAGE 98 LINE 42

