

STATE OF KANSAS
STATE CORPORATION COMMISSION

Form CP-4


Give All Information Completely
Make Required Affidavit
Mail or Deliver Report to:
Conservation Division
State Corporation Commission
212 No. Market
Wichita, Kansas

WELL PLUGGING RECORD

Kingman County, Sec. 12 Twp. 30S Rge. (X) 10 (W)

Location as "NE/CNW/SW" or footage from lines. C NW SW
Lease Owner E. K. Edmiston, et al
Lease Name Carter Well No. 1
Office Address 425 First Natl Bank Bldg., Wichita, Ks.
Character of Well (completed as Oil, Gas or Dry Hole) dry hole
Date well completed June 9, 19 67
Application for plugging filed June 12, 19 67
Application for plugging approved 19
Plugging commenced June 9, 19 67
Plugging completed June 9, 19 67
Reason for abandonment of well or producing formation dry hole

NORTH

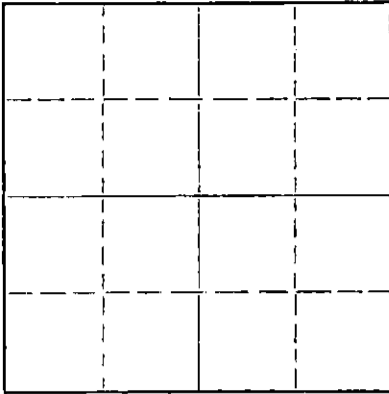

Locate well correctly on above Section Plat

If a producing well is abandoned, date of last production 19
Was permission obtained from the Conservation Division or its agents before plugging was commenced? yes

Name of Conservation Agent who supervised plugging of this well Archie Elving
Producing formation Depth to top Bottom Total Depth of Well 2580 Feet
Show depth and thickness of all water, oil and gas formations.

OIL, GAS OR WATER RECORDS

CASING RECORD

FORMATION	CONTENT	FROM	TO	SIZE	PUT IN	PULLED OUT
Surface pipe		-0-	241	8-5/8"	6/5/67	none

Describe in detail the manner in which the well was plugged, indicating where the mud fluid was placed and the method or methods used in introducing it into the hole. If cement or other plugs were used, state the character of same and depth placed, from feet to feet for each plug set.

Bottom plug set @ 230' w/25 sacks cement;
Top plug set @ 40' w/10 sacks cement;
Two sacks in rat hole.

RECEIVED
STATE CORPORATION COMMISSION
JUN 14 1967
CONSERVATION DIVISION
Wichita, Kansas

(If additional description is necessary, use BACK of this sheet)

Name of Plugging Contractor E. K. Edmiston Drlg. Co., Inc.
Address 425 First Natl Bank Bldg., Wichita, Kansas 67202

STATE OF KANSAS COUNTY OF SEDGWICK, ss.
E. K. Edmiston (owner or operator) of the above-described

well, being first duly sworn on oath, says: That I have knowledge of the facts, statements, and matters herein contained and the log of the above-described well as filed and that the same are true and correct. So help me God.

(Signature) [Signature]
425 First Natl Bank Bldg., Wichita, Ks. (Address)

Subscribed and sworn to before me this 12th day of June, 1967

My commission expires November 9, 1969

[Signature]
Marilyn E. Fox
Notary Public.

DRILLER'S LOG

COMPANY: E. K. Edmiston
 425 First National Bank Building
 Wichita, Kansas 67202

ROTARY DRILLING COMMENCED: June 5, 1967

ROTARY DRILLING COMPLETED: June 9, 1967

WELL NAME: CARTER No. 1

LOCATION: C NW SW Sec. 12-30S-10W
 Kingman County, Kansas

CONTRACTOR: E. K. Edmiston Drilling Co., Inc.
 425 First National Bank Building
 Wichita, Kansas 67202

CASING RECORD: Set 241' of 8-5/8" surface pipe
 with 200 sacks Posmix

L O G


Measurements from top of Kelly Bushing; Elevation 1729 K.B.

Surface Clay	0 - 20
Sand	115
Red Bed	590
Red Bed and Shale	700
Shale and Shells	1555
Lime and Shale	1830
Lime	2165
Broken Lime	2440
Lime	2580 R.T.D.

RECEIVED
 STATE CORPORATION COMMISSION
 JUN 14 1967
 CONSERVATION DIVISION
 Wichita, Kansas

The undersigned, E. K. Edmiston, President of E. K. Edmiston Drilling Co., Inc., hereby certifies on behalf of said company, that the above log is a true and correct log of the formations encountered in drilling the above well, as reflected by the daily drilling reports.

E. K. EDMISTON DRILLING CO., INC.


By: 
 E. K. Edmiston, President

STATE OF KANSAS)
) SS:
 COUNTY OF SEDGWICK)

BE IT REMEMBERED that on this 12th day of June, 1967, before me, the undersigned, a Notary Public within and for the County and State aforesaid, came E. K. Edmiston, known to me to be the same person who executed the foregoing instrument as President and on behalf of the E. K. Edmiston Drilling Co., Inc., and he duly acknowledged the execution of the same for himself and for said company.

IN WITNESS WHEREOF, I have hereunto set my hand and official seal on the day and year last above written.

My Commission Expires:
 November 9, 1969

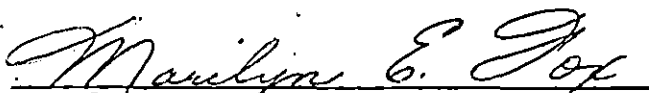
 Marilyn E. Fox, Notary Public

