


WELL PLUGGING RECORD

Give All Information Completely
Make Required Affidavit
Mail or Deliver Report to:
Conservation Division
State Corporation Commission
211 No. Broadway
Wichita, Kansas

NORTH

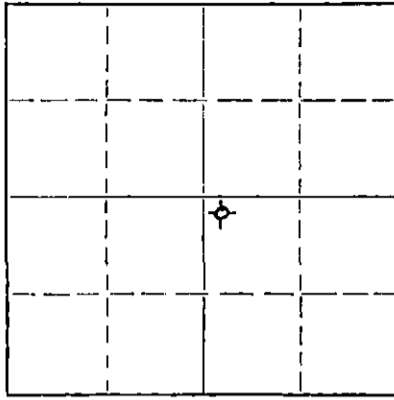

Locate well correctly on above Section Plat

Stafford County, Sec. 32 Twp. 24 Rge 12 XXX (W)
Location as "NE/CNW%SW%" or footage from lines NW NW SE
Lease Owner D. R. Lauck Oil Company, Inc.
Lease Name Wright Well No. 1
Office Address 301 South Broadway Wichita Kans
Character of Well (completed as Oil, Gas or Dry Hole) dry hole
Date well completed June 1 19 56
Application for plugging filed June 1 19 56
Application for plugging approved June 1 19 56
Plugging commenced June 1 19 56
Plugging completed June 1 19 56
Reason for abandonment of well or producing formation dry hole

If a producing well is abandoned, date of last production - - 19 -
Was permission obtained from the Conservation Division or its agents before plugging was commenced? YES

Name of Conservation Agent who supervised plugging of this well F. R. M. Brundage
Producing formation _____ Depth to top _____ Bottom _____ Total Depth of Well 4210 Feet
Show depth and thickness of all water, oil and gas formations.

OIL, GAS OR WATER RECORDS

CASING RECORD

FORMATION	CONTENT	FROM	TO	SIZE	PUT IN	PULLED OUT
		0	231'	8 5/8"	231	none

Describe in detail the manner in which the well was plugged, indicating where the mud fluid was placed and the method or methods used in introducing it into the hole. If cement or other plugs were used, state the character of same and depth placed, from _____ feet to _____ feet for each plug set.

hole filled with mud

mud 4210 - 240
plug 240 - 236
cement 236 - 186
mud 186 - 35
plug 35 - 31
cement 31 - 6 bottom of cellar

6-6-56

(If additional description is necessary, use BACK of this sheet)

Name of Plugging Contractor Globe Cementing Company
Address Great Bend Kansas

STATE OF Kansas, COUNTY OF Sedgwick, ss.
John H. Knightley (employee of owner) or (owner or operator) of the above-described well, being first duly sworn on oath, says: That I have knowledge of the facts, statements, and matters herein contained and the log of the above-described well as filed and that the same are true and correct. So help me God.

(Signature) John H. Knightley
Wichita Kansas
(Address)

SUBSCRIBED AND SWORN TO before me this 5th day of June, 19 56

My commission expires Sept. 14, 1959

Elizabeth Gay
Notary Public.

PLUGGING
FILE SEC. 32 T. 24 R. 14w
BOOK 67 LINE 36

D. R. Lauck Oil Company, Inc.

Wright No.1

NW NW SE Sec.32-24S-12W
Stafford County, Kansas

Commenced: May 19, 1956

Completed: June 1, 1956

Casing Record: 231' 8 5/8" com.w/200 sacks

Elevation: GR 1898; DF 1901; KB 1903;

Drillers LogTopsSampleHalliburton

sand & shells	157	Heebner	3391-1498	3391-1498
Red bed & shells	315	Douglas	3432-1529	3432-1529
red bed	550	Brown lime	3548-1645	3548-1645
red bed & shale	720	Lansing-KC	3572-1669	3572-1669
anhydrite	745	Base KC	3855-1952	3852-1949
shale	870	Viola	3994-2091	3988-2085
shale & shells	1195	Simpson shale	4112-2209	4113-2210
shale & shells, salt	1410	Arbuckle	4176-2273	4178-2275
lime	1435	Rotary TD	4210-2307	4210-2307
shale & shells	1565			
lime	1570			D & A
lime & shale	2320			
shale & shells	2380			
lime & shale	2700			
shale & shells	2770			
lime & shale	3190			
lime	3355			
lime & shale	3520			
shale	3550			
lime & shale	3580			
lime	3915			
lime & shale	4005			
chert	4035			
chert & shale	4113			
shale & lime	4176			
Arbuckle	4210			
rotary total depth 4210				

PLUGGING

FILE SEC. 32 T. 24 R. 14W
BOOK PAGE 67 LINE 36