

STATE OF KANSAS  
STATE CORPORATION COMMISSION

WELL PLUGGING RECORD

OR

FORMATION PLUGGING RECORD

Strike out upper line when reporting plugging of formations.

Give All Information Completely  
Make Required Affidavit  
Mail or Deliver Report to:  
Conservation Division  
State Corporation Commission  
800 Bittling Building  
Wichita, Kansas

RENO

County. Sec. 14 Twp. 23S Rge. (E) 4 (W)

Location as "NE 1/4 NW 1/4 SW 1/4" or footage from lines. SW SE NE 1/4

Lease Owner. OLSON OIL COMPANY

Lease Name. E. R. Downie Well No. 2

Office Address. Drawer 588, Tulsa, Okla.

Character of Well (completed as Oil, Gas or Dry Hole) Oil

Date, well completed. 11-28-1934

Application for plugging filed. 11-30-1940

Application for plugging approved. 12-3-1940


Plugging Commenced. 12-4-1940

Plugging Completed. 12-10-1940

Reason for abandonment of well or producing formation Well went to water.

If a producing well is abandoned, date of last production 3-5-1940

Was permission obtained from the Conservation Division or its agents before plugging was commenced? Yes

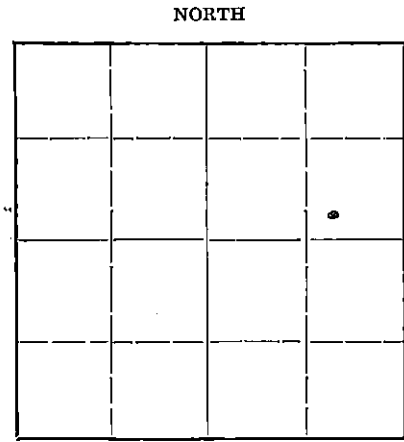

Locate well correctly on above Section Plat

Name of Conservation Agent who supervised plugging of this well. Ruel Durkee

Producing formation. Hunton Lime Depth to top. 3588 Bottom. 3604 Total Depth of Well. 3604 Feet

Show depth and thickness of all water, oil and gas formations.

OIL, GAS OR WATER RECORDS

CASING RECORD

Formation	Content	From	To	Size	Put In	Pulled Out
Chat	Water	3253	3351	1 1/2"	251'	None
Hunton Lime	Oil	3588	3604	7"	3578	2397 ft.

Describe in detail the manner in which the well was plugged, indicating where the mud fluid was placed and the method or methods used in introducing it into the hole. If cement or other plugs were used, state the character of same and depth placed, from feet to feet for each plug set.

Filled hole with Chat from 3604 to 3575, put in 10 ft. rock and run in 6 sacks of cement. Mudded hole to 260 ft. Set bridge at 260 ft. and put in 10 ft. of rock to 250 ft. run in 20 sacks of cement. Mudded to top, run in 5 sacks of cement in surface pipe at base of cellar.

PLUGGING  
FILE SEC 14 T 23R 4W  
BOOK PAGE 24 LINE 2

DEC 3 1940  
FILED  
CONSERVATION DIV.

(If additional description is necessary, use BACK of this sheet)

Correspondence regarding this well should be addressed to S. A. Keefover

Address. Box R Burrton, Kansas

STATE OF KANSAS, COUNTY OF RENO, ss.

S. A. Keefover (employee of owner) or (owner) of the above-described well, being first duly sworn on oath, says: That I have knowledge of the facts, statements, and matters herein contained and the log of the above-described well as filed and that the same are true and correct. So help me God.

(Signature) S. A. Keefover

(Address)

SUBSCRIBED AND SWORN to before me this 12 day of December, 1940

My commission expires 4/20/42

G. J. Bryant  
Notary Public.



OLSON OIL COMPANY  
E. R. DOWNIE # 2  
SW SE NE 14-23S-4W  
RENT COUNTY, KANSAS


COMMENCED 10-28-34  
COMPLETED 11-28-34  
ELEVATION 1472'

130 Sand  
163 Sand  
190 Shale  
198 Sand  
250 Shale & shells  
422 Shale & shells  
584 Shale & lime  
667 Shale & shells  
819 Shale & lime  
869 Shale & shells  
885 Shale  
920 Lime  
934 Shale & shells  
1070 Shale & lime  
1840 Shale & shells  
63 Lime  
1953 Shale & shells  
2039 Shale & lime  
83 Shale & shells  
2130 Shale  
2310 Shale & lime  
2416 Lime & shale  
87 Sandy shale  
94 Lime  
2535 Shale  
50 Lime  
2604 Lime & shale  
40 Lime  
2750 Lime & shale  
3048 Lime  
66 Shale  
3201 Shale & shells  
53 Var. Shale  
3351 Chat  
84 Lime  
3452 Lime & chat  
80 Lime  
3588 Shale  
3591 Lime, R.U.S.T.  
3604 Lime, T.D.

CASING RECORD

15 $\frac{1}{2}$ " 70# 251'  
7" 24# 3578'

PLUGGING  
FILE - SEC 14 ~~33~~ 4W  
BOOK PAGE 124 LINE --- 2

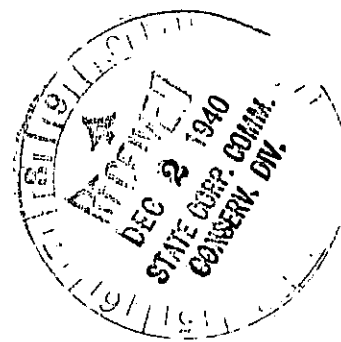

Subscribed and sworn to before me  
this 20th day of Nov. 1940

G. J. Bergant  
Notary Public  
My commission expires April 20, 1942

I hereby certify that the above is  
a true and correct copy of the log of  
E. R. Downie # 2 SW SE NE/4, Sec 14,  
T 23S, R 4W, Reno County, Kansas

J. A. Keesler