

STATE OF KANSAS
STATE CORPORATION COMMISSION


WELL PLUGGING RECORD

OR
FORMATION PLUGGING RECORD

Give All Information Completely
Make Required Affidavit
Mail or Deliver Report to:
Conservation Division
State Corporation Commission
800 Bittling Building
Wichita, Kansas

Strike out upper line
when reporting plug-
ging off formations.

Reno County. Sec. 14 Twp. 23S Rge. ~~25~~ 4 (W)
Location as "NE $\frac{1}{4}$ NW $\frac{1}{4}$ SW $\frac{1}{4}$ " or footage from lines SW SW NE
Lease Owner. Olson Drilling Co.
Lease Name. E.R. Downie Well No. 3
Office Address. P.O. Drawer 2680, Tulsa 1, Oklahoma
Character of Well (completed as Oil, Gas or Dry Hole). Oil
Date well completed. Jan. 27, 1935
Application for plugging filed. Sept. 7, 1946
Application for plugging approved. Sept. 10, 1946
Plugging commenced. Dec. 14, 1946
Plugging completed. Dec. 20, 1946
Reason for abandonment of well or producing formation. Oil exhausted

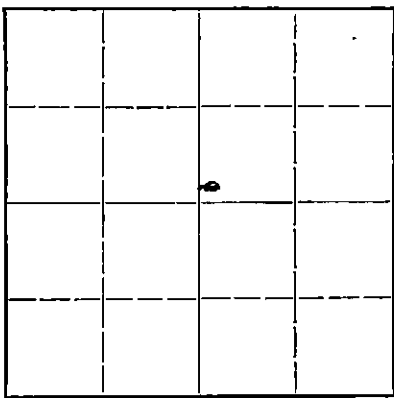

Locate well correctly on above
Section Plat

If a producing well is abandoned, date of last production. July 5, 1946
Was permission obtained from the Conservation Division or its agents before plugging was com-
menced? Yes

Name of Conservation Agent who supervised plugging of this well. Mr. Ruel Durkee
Producing formation. Hunton Depth to top. 3596 Bottom. 3606 Total Depth of Well. 3606 Feet
Show depth and thickness of all water, oil and gas formations.

OIL, GAS OR WATER RECORDS


CASING RECORD

| Formation | Content | From | To | Size | Put In | Pulled Out |
|-----------|---------|------|------|--------------------|--------|------------|
| Hunton | Oil | 3596 | 3606 | 12 $\frac{1}{8}$ " | 253' | None |
| | | | | 10" | 540' | 119 ft. |
| | | | | 7" | 3585' | 600 " |

Describe in detail the manner in which the well was plugged, indicating where the mud fluid was placed and the method or methods used in introducing it into the hole. If cement or other plugs were used, state the character of same and depth placed, from.....feet to.....feet for each plug set.

Put in crushed rock from 3606 to 3594 ft.
Ran 6 sacks of cement at 3594 ft.
Mudded hole to 300 ft.
Set rock bridge at 300 ft. ran 25 sack of cement at 300 ft.
Mudded hole to 15 ft.
Ran 8 sacks of cement for cap in cellar.

DRILLING
FILE 14 23 46
BOOK PAGE 70 LINE 34

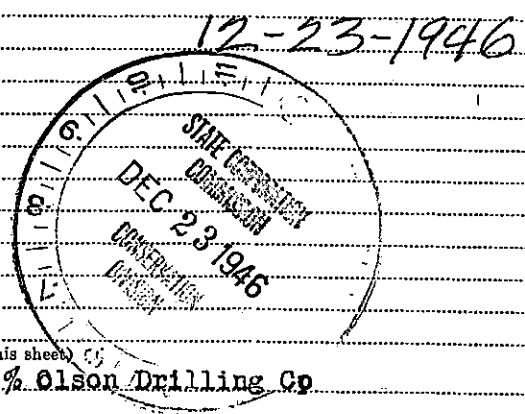

(If additional description is necessary, use BACK of this sheet)
Correspondence regarding this well should be addressed to. S.A. Keefover % Olson Drilling Co.
Address. Burrton, Kansas

STATE OF Kansas, COUNTY OF Harney, ss.
J. L. Mc Menis (employee of owner) or (owner or operator) of the above-described well,
being first duly sworn on oath, says: That I have knowledge of the facts, statements, and matters herein contained and the log of the above-
described well as filed and that the same are true and correct. So help me God.

(Signature) J. L. Mc Menis

SUBSCRIBED AND SWORN to before me this 21st day of December, 1946

My commission expires 7/22/48 (Address) A. L. Heedlund, Notary Public.