

STATE OF KANSAS
STATE CORPORATION COMMISSION

WELL PLUGGING RECORD


Give All Information Completely
Make Required Affidavit
Mail or Deliver Part to:
Conservation Division
State Corporation Commission
800 Bitting Building
Wichita, Kansas

OR

FORMATION PLUGGING RECORD

Strike out upper line
when reporting plug-
ging of formations.

NORTH

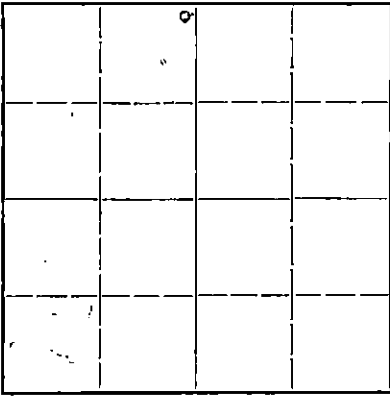

Locate well correctly on above
Section Plat

Reno County. Sec. 14 Twp. 23S Rge. (E) 4 (W)
Location as "NE 1/4 NW 1/4 SW 1/4" or footage from lines. NE NE NW
Lease Owner. Olson Drilling Co.
Lease Name. G.M. Harnar Well No. 2
Office Address. Tulsa, Oklahoma
Character of Well (completed as Oil, Gas or Dry Hole). Oil
Date well completed. Feb. 26 19 35
Application for plugging filed. Oct. 15 19 45
Application for plugging approved. Oct. 16 19 45
Plugging commenced. Dec. 7 19 45
Plugging completed. Dec. 11 19 45
Reason for abandonment of well or producing formation. Well went dry

If a producing well is abandoned, date of last production. Test 8-9 19 45
Was permission obtained from the Conservation Division or its agents before plugging was com-
menced? Yes

Name of Conservation Agent who supervised plugging of this well. Ruel Durkee
Producing formation. Hunton Depth to top. 3605 Bottom. 3625 Total Depth of Well. 3625 Feet
Show depth and thickness of all water, oil and gas formations.

OIL, GAS OR WATER RECORDS

CASING RECORD

Formation	Content	From	To	Size	Put In	Pulled Out
Hunton Lime	Oil	3605	3625	15 1/8" 7"	253' 3615'	None 2710.65'

Describe in detail the manner in which the well was plugged, indicating where the mud fluid was placed and the method or methods used in introducing it into the hole. If cement or other plugs were used, state the character of same and depth placed, from _____ feet to _____ feet for each plug set.

Filled hole with crushed rock from 3625 to 3615, filled with 6 sacks of cement from 3615' to 3585', Filled with mud from 3585 to 250', filled with 30 sacks of cement from 250 to 220, filled with mud from 220 to 15', from 15' to cellar cap with 10 sacks of cement.

FILE 14 23 4W
LOOK PAGE 28 22



(If additional description is necessary, use BACK of this sheet)

Correspondence regarding this well should be addressed to J.L. McMannis % Olson Drilling Co.
Address. Burrton, Kansas

STATE OF Kansas COUNTY OF Reno Harvey, ss.
J.L. McMannis (employee of owner or (owner or operator) of the above-described well,
being first duly sworn on oath, says: That I have knowledge of the facts, statements, and matters herein contained and the log of the above-described well as filed and that the same are true and correct. So help me God.

(Signature) J.L. McMannis

SUBSCRIBED AND SWORN to before me this 12th day of December 19 45

My commission expires 7-22-48 Notary Public.

15-155-02537-0000

Olson Drilling Co.
G.M. Harner # 2
NE NE NW 14-23S-4W


COMMENCED 1-23-35
COMPLETED 2-26-35
Elevation 1502'

- 0
- 74-- Sand
- 140-- Sand & clay
- 476--Shale
- 540-- Broken lime
- 790--Shale & lime shells
- 811--Lime
- 852--Shale & lime shells
- 950-- Broken lime
- 965--Lime
- 985--Shale
- 1060--Broken lime
- 1270--Shale & lime shells
- 85--Sandy shale
- 1502--Shale & lime shells
- 47--Broken lime
- 1716--Shale & lime shells
- 94--Shale
- 1840--Shale & lime shells
- 85--Shale
- 2429--Broken lime
- 90--Sandy shale
- 2614--Shale
- 2946--Lime
- 91--Broken lime
- 3040--Lime
- 81--Broken lime
- 3141--Lime & shale
- 3227--Shale & lime shells
- 77--Var. Shale
- 3386--Chat
- 3426--Lime & chat
- 37--Chat
- 3505--Lime
- 3615--Shale
- 17--Lime, RUST
- 25--Lime, T.D.

CASING RECORD

15 1/2"	55#	253'
7"	24#	3615'

FILE 14 23 4 (C)
BOOK PAGE 28 22

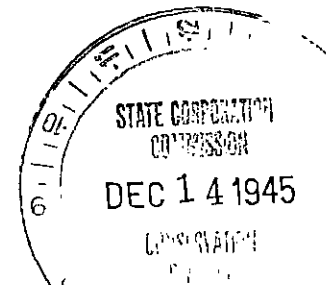

Subscribed and sworn to before me this 12th day of December 1945

A. C. Kindschick
Notary Public

My Commission expires 7/22/48

I hereby certify that the above is a true and correct copy of the log of G.M. Harner #2 NE NE NW 14-23S-4W

J. L. McManis