

15-155-02544-0000

STATE OF KANSAS
STATE CORPORATION COMMISSION

WELL PLUGGING RECORD

Give All Information Completely
Make Required Affidavit
Mail or Deliver Report to:
Conservation Division
State Corporation Commission
800 Bittling Building
Wichita, Kansas


OR

Strike out upper line
when reporting plug-
ging of formations.

~~FORMATION PLUGGING RECORD~~

SW/4 Location as "NE1/4NW1/4SW1/4" or footage from lines 330' fm East 380' fm Sth lines
Reno County. Sec. 14 Twp. 23S Rge. (E) 4 (W)

NORTH

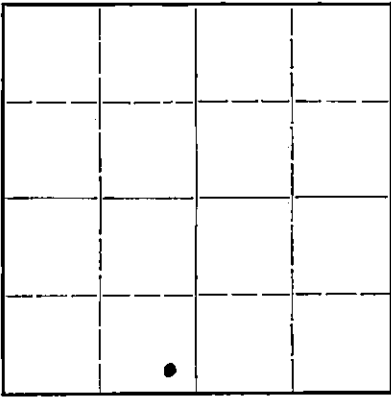

Locate well correctly on above
Section Flat

Lease Owner. Sinclair Prairie Oil Co
Lease Name. George M. Harner Well No. 2
Office Address. Bx 521, Tulsa, Okla.
Character of Well (completed as Oil, Gas or Dry Hole). oil
Date well completed. Jan 26 19 35
Application for plugging filed. 19
Application for plugging approved. 19
Plugging commenced. Aug 22 19 45
Plugging completed. Aug 31 19 45
Reason for abandonment of well or producing formation. production exhausted

If a producing well is abandoned, date of last production. May 19 44
Was permission obtained from the Conservation Division or its agents before plugging was com-
menced? yes, verbal permission

Name of Conservation Agent who supervised plugging of this well. Ruel Durkee
Producing formation. Depth to top. Bottom. Total Depth of Well. 3372 Feet
Show depth and thickness of all water, oil and gas formations.



OIL, GAS OR WATER RECORDS

CASING RECORD

Formation	Content	From	To	Size	Put In	Pulled Out
Chat	dry	3260	3372	15 1/2"	254'	0
				8-5/8	3594	2371'

Describe in detail the manner in which the well was plugged, indicating where the mud fluid was placed and the method or methods used in introducing it into the hold. If cement or other plugs were used, state the character of same and depth placed, from feet to feet for each plug set.

Rock to 3265'
Cement 3265-3240'
Heavy Mud 3240-250'
Cement 250-230'
Heavy Mud 230-10'
Cement 10' to Surface

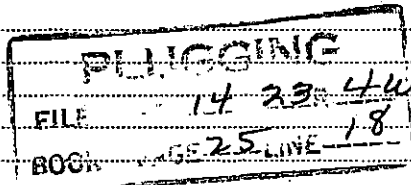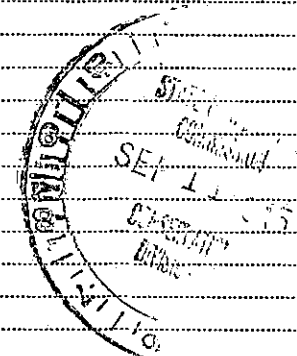

9-11-1945

(If additional description is necessary, use BACK of this sheet)

Correspondence regarding this well should be addressed to J.W. Stoker
Address. Bx 774 Great Bend, Kas

STATE OF Kansas, COUNTY OF Barton, ss.
I, J.W. Stoker (employee of owner) or (Inspector) of the above-described well,
being first duly sworn on oath, says: That I have knowledge of the facts, statements, and matters herein contained and the log of the above-described well as filed and that the same are true and correct. So help me God.

(Signature)

Bx 774 Great Bend, Kas
(Address)

SUBSCRIBED AND SWORN to before me this 10th day of September, 1945

Notary Public.

My commission expires 6-14-47

SINCLAIR PRAIRIE OIL CO.

Well Log

George W. Harner # 2
 S7/4, 14-23S-4W Reno Co., Kas.
 Completed in January 1935.

15-155-02544-0000

Shale & Shells	1018'	
Lime	1045'	
Lime & Shale	1100	15 1/2" OD 70# csg at 254'
Shale & Shells	1145	w/250 sx cmt.
Shale & Broken Lime	1220	
Shale & Shells	1358	8-5/8" 32# csg at 3594'
Shale & Lime	1405	w/350 sx cmt.
Shale	1755	
Shale & Shells	1782	
Shale & Lime	1908	
Broken Lime	1948	
Shale & Lime	2006	
Broken Lime	2044	
Lime Shale	2131	
Shale & Shells	2217	
Lime Shale	2255	
Lime	2294	
Shale	2352	
Lime & Shale	2433	
Lime	2470	
Shale	2520	
Lime	2743	
Shale-Lime-Shells	2787	
Broken Lime	2972	
Lime Shale	3004	
Shale	3028	
Shale Lime	3054	
Shale	3190	Top Chat 3260'
Shale & Shells	3229	Top Hunton 3593'
Shale	3255	
Chat	3381	
Chat & Lime	3429	
Lime	3500	
Shale	3594	
Lime	3608	
Hard Lime	3611	

Plugged back to TD 3372' in Chat in Feb. 1945
 and perforated 3265-75' 3289-3304' 3330-3334' 3341-3370'



14 23 4W
 25 18