


WELL PLUGGING RECORD

15-155-20006-0000

Give All Information Completely.
Make Required Affidavit
Mail or Deliver Report to:
Conservation Division
State Corporation Commission
212 No. Market
Wichita, Kansas

Reno County, Sec. 14 Twp. 23 Rge. 4 (E) (W)
CW/2 SE/4

Location as "NE/CNW/SW" or footage from lines
Lease Owner Charles D. Johnson
Lease Name Hensley Well No. 1
Office Address McPherson, Kansas
Character of Well (completed as Oil, Gas or Dry Hole) _____
Date well completed _____ 19____
Application for plugging filed JAN 2 1968 19____
Application for plugging approved 12/11/67 19____
Plugging commenced 12/14/67 19____
Plugging completed _____ 19____
Reason for abandonment of well or producing formation depleted.

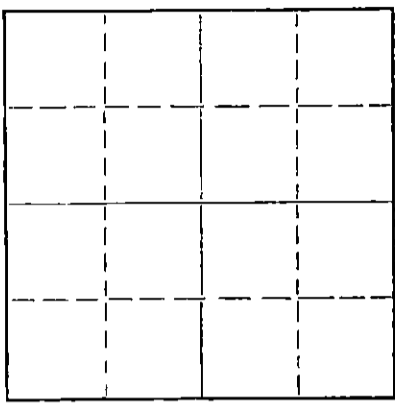

Locate well correctly on above Section Plat

If a producing well is abandoned, date of last production _____ 19____
Was permission obtained from the Conservation Division or its agents before plugging was commenced? yes

Name of Conservation Agent who supervised plugging of this well Touhan
Producing formation _____ Depth to top _____ Bottom _____ Total Depth of Well 3720 Feet
Show depth and thickness of all water, oil and gas formations.

OIL, GAS OR WATER RECORDS

CASING RECORD

FORMATION	CONTENT	FROM	TO	SIZE	PUT IN	PULLED OUT
				13"	257'	none
				5-1/2"	3918'	3010'

Describe in detail the manner in which the well was plugged, indicating where the mud fluid was placed and the method or methods used in introducing it into the hole. If cement or other plugs were used, state the character of same and depth placed, from _____ feet to _____ feet for each plug set.

Checked hole to 3718', ran sand from 3718 to 3700' and dumped 5 sacks of cement. Loaded hole with water, worked tension to 23", shot pipe at 3206', 3108', and 3013', worked pipe loose. Set rock bridge from 260 to 250' and dumped 25 sacks of cement. Mudded to 40', set 10' rock bridge and dumped 10 sacks of cement.

PLUGGING COMPLETE.

*Recd
12-8-67*

(If additional description is necessary, use BACK of this sheet)

Name of Plugging Contractor KNIGHT CASING PULLING CO., INC.
Address CHASE, KANSAS


STATE OF KANSAS COUNTY OF RICE, ss.
NOEL J. KNIGHT (employee of owner) or (owner or operator) of the above-described well, being first duly sworn on oath, says: That I have knowledge of the facts, statements, and matters herein contained and the log of the above-described well as filed and that the same are true and correct. So help me God.

(Signature) Noel Knight
CHASE, KANSAS
(Address)

SUBSCRIBED AND SWORN to before me this 15th day of December, 19 67

My commission expires February 15, 1971

Margaret Melcher
Notary Public.

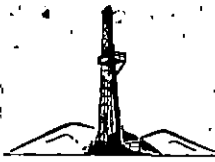

15-155-26006-0000

Blackstone Drilling, Inc.

Box 455 • 523 West Kansas • Phone CH 1-1250

McPHERSON • KANSAS
67460

April 17, 1967

COMPANY: CHARLES D. JOHNSON
 CONTRACTOR: BLACKSTONE DRILLING, INC.
 FARM: HENSLEY # 1
 LOCATION: C-W/2 SE/4, Sec. 14-23-4W,
 Reno County, Kansas
 COMMENCED: April 7, 1967
 COMPLETED: April 17, 1967
 ELEVATION: 1474 K.B.

0	to	50	Sand & Clay
50	to	210	Clay & Redbed
210	to	257	Blue Shale
257	to	460	Shale
460	to	1865	Lime & Shale
1865	to	2125	Shale & Lime
2125	to	2290	Lime
2290	to	2545	Lime & Sand
2545	to	2715	Lime & Shale
2715	to	3015	Lime
3015	to	3130	Lime & Shale
3130	to	3252	Shale & Lime
3252	to	3446	Mississippi
3446	to	3490	Lime
3490	to	3590	Shale & Lime
3590	to	3612	Lime & Chert
3612	to	3660	Lime & Shale
3660	to	3720	Shale & Lime
		3720	T. D.

DEC 8 1967
 COMPLETION DIVISION
 Wichita, Kansas

Cut 17 1/4 in. hole to 257 ft. and run 260 ft. of 13 in. surface pipe and cemented on bottom at 257 ft. with 250 sacks cement. Plug down at 9:00 P.M., April 8, 1967. Cut 12 1/4 in. hole to 571 ft. and run 571.45 ft. of 8 5/8 in. surface pipe and cemented on bottom at 571 ft. with 100 sacks cement. Cut 7 7/8 in. hole to 3720 ft. and run 3720.78 ft. of 5 1/2 in casing and cemented 2 foot off bottom at 3718 ft. with 90 sacks cement. Plug down at 6:30 A.M., April 17, 1967. 35 Bbls. oil mixed in mud.

TOPS: Lansing - 2534' Mississippi - 3251' Kinderhook - 3475' Hiener - 3565'
 Hunton - 3586' Maquoketa - 3615' Viola - 3694' Simpson - 3718'

Measurements taken from K. B.

CERTIFICATE

I, H. J. Plouffe, President of Blackstone Drilling, Inc. do hereby certify that the above and foregoing is a true and correct copy of log on your Hensley #1, located on the C-W/2 SE/4 of Sec. 14-23-4W, Reno County, Kansas as reflected by the files of Blackstone Drilling, Inc.

H. J. Plouffe
 H. J. Plouffe - President

Subscribed and sworn to before me a Notary Public in and for McPherson County, Kansas this 17th day of April, 1967.

Ruth McVay
 Ruth McVay, Notary Public

My Commission Expires: December 18, 1969.