

15-155-02540-0000

STATE OF KANSAS
STATE CORPORATION COMMISSION

WELL PLUGGING RECORD

Give All Information Completely
Make Required Affidavit
Mail or Deliver Report to:
Conservation Division
State Corporation Commission
300 Bittling Building
Wichita, Kansas

OR

FORMATION PLUGGING RECORD

Strike out upper line
when reporting plug-
ging off formations.

Reno County. Sec. 14 Twp. 23 Rge. 4 (E) 4 (W)

Location as "NE 1/4 NW 1/4 SW 1/4" or footage from lines. SE 1/4 SE 1/4

Lease Owner Chas. L. Jenkins

Lease Name Ackley Well No. 1

Office Address Box 603, Blackwell, Oklahoma

Character of Well (completed as Oil, Gas or Dry Hole) Gas

Date well completed August 19, 19 34

Application for plugging filed 19

Application for plugging approved 19


Plugging commenced September 23, 19 46

Plugging completed October 2, 19 46

Reason for abandonment of well or producing formation. Production too low
to warrant producing well.

If a producing well is abandoned, date of last production September 19 46

Was permission obtained from the Conservation Division, or its agents before plugging was com-
menced? Yes

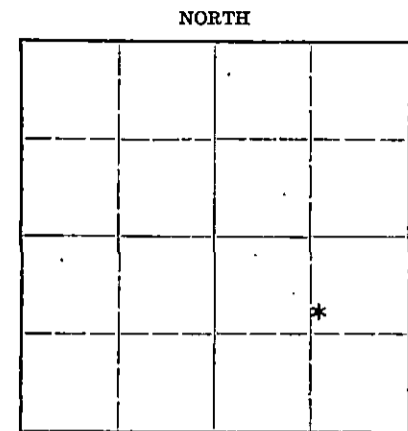

Locate well correctly on above
Section Plat

Name of Conservation Agent who supervised plugging of this well Mr. Ruel Durkee

Producing formation Chat Depth to top 3255 Bottom 3390 Total Depth of Well 3409 Feet

Show depth and thickness of all water, oil and gas formations.

OIL, GAS OR WATER RECORDS

CASING RECORD

Formation	Content	From	To	Size	Put In	Pulled Out
Chat	Gas	3255	3390	15-1/2	248'	
				8-1/4	3260'	2420'
				5-3/16	3376'	3376'

Describe in detail the manner in which the well was plugged, indicating where the mud fluid was placed and the method or methods used in introducing it into the hold. If cement or other plugs were used, state the character of same and depth placed, from _____ feet to _____ feet for each plug set.

Dumped six sacks of cement in bottom of the hole and then shot pipe off at 2400' and mudded hole to 200' and put 25 sacks of cement at 200'. Finished filling surface with mud and put 10 sacks of cement at top of hole.

MAY 10 1947

5-19-1947

(If additional description is necessary, use BACK of this sheet)

Correspondence regarding this well should be addressed to Chas. L. Jenkins
Address Box 603, Blackwell, Oklahoma

STATE OF Oklahoma, COUNTY OF Kay, ss.
C. C. Jenkins (employee of owner) of the above-described well,
being first duly sworn on oath, says: That I have knowledge of the facts, statements, and matters herein contained and the log of the above-described well as filed and that the same are true and correct. So help me God.

(Signature) *C. C. Jenkins*

Box 603, Blackwell, Oklahoma
(Address)

SUBSCRIBED AND SWORN to before me this 9th day of May, 19 47.

My commission expires June 4, 1950

Notary Public.

PLUGGING
FILE SEC 4 T 23 R 4 W
BOOK PAGE 99 LINE 2

15-155-02540-0000

WELL LOG

Ackley #1, Center of the Southeast of the SE/4, Sec 14-23-4,
Reno County, Kansas.

Formation	to
Surface Clay	248'
Shale & Gyp	615'
Shale	660'
Salt	735'
Salt & Shale	820'
Shale & Shells	900'
Shale & Lime	1450'
Shale & Shells	1650'
Broken Lime	1675'
Shale & Shells	1740'
Lime	1845'
Broken Lime	1850'
Shale	1870'
Broken Lime	1920'
Shale & Shells	1990'
Lime	2058'
Lime	2140'
Hard Shale	2235'
Shale & Lime	2295'
Broken Lime	2335'
Shale	2340'
Lime	2420'
Water Sand	2446'
Shale & Sand	2475'
Broken Lime	2495'
Lime	2815'
Shale & Shells	2840'
Broken Lime	2865'
Hard Brown Lime	2890'
Lime	2980'
Shale	3005'
Broken Lime	3030'
Shale	3070'
Lime	3095'
Shale Sticky	3165'
Shale	3198'
Sticky Shale	3230'
Mixed Shale	3255'
Chat	3390'
Lime (total depth)	3409'

MAY 10 1947

PLUGGING			
FILE	SEC 14	T 29	R 40
BOOK	PAGE 99	LINE	2