

STATE OF KANSAS
STATE CORPORATION COMMISSION

WELL PLUGGING RECORD

OR
FORMATION PLUGGING RECORD


Strike out upper line
when reporting plug-
ging off formations.

Give All Information Completely
Make Required Affidavit
Mail or Deliver Report to:
Conservation Division
State Corporation Commission
800 Bittling Building
Wichita, Kansas

RENO County. Sec. 13 Twp. 23S Rge. (E) 4 (W)

Location as "NE 1/4 NW 1/4 SW 1/4" or footage from lines. C SE SW/4
Lease Owner OISON OIL COMPANY
Lease Name M. E. Sabin "B" Well No. 4
Office Address Pet. Bldg. Tulsa, Okla.
Character of Well (completed as Oil, Gas or Dry Hole) Oil & Gas
Date, well completed 7 - 17 - 19 36
Application for plugging filed 10 - 20 - 19 41
Application for plugging approved 10 - 21 - 19 41
Plugging Commenced 12 - 11 - 19 41
Plugging Completed 12 - 19 - 19 41
Reason for abandonment of well or producing formation Non-productive.

NORTH

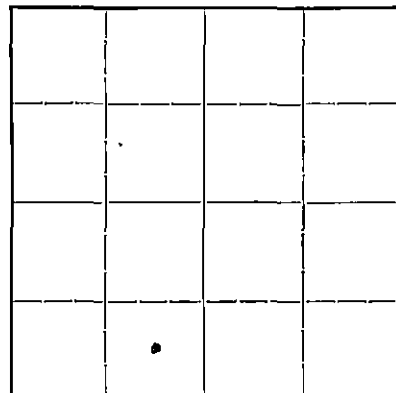

Locate well correctly on above
Section Plat

If a producing well is abandoned, date of last production 9 - 27 - 19 41
Was permission obtained from the Conservation Division or its agents before plugging was com-
menced? Yes

Name of Conservation Agent who supervised plugging of this well Ruel Durkee
Producing formation Chat Depth to top 3252 Bottom 3374 Total Depth of Well 3374 Feet
Show depth and thickness of all water, oil and gas formations.

OIL, GAS OR WATER RECORDS

CASING RECORD

Formation	Content	From	To	Size	Put In	Pulled Out
Chat	Oil & Gas	3324	3374	13"	251	None
				7"	3266	3047

Describe in detail the manner in which the well was plugged, indicating where the mud fluid was placed and the method or methods used in introducing it into the hole. If cement or other plugs were used, state the character of same and depth placed, from feet to feet for each plug set.

Mudded hole from bottom to 3270 ft. dumped 6 sacks of cement at 3270.
Mudded hole to 150 ft. dumped 15 sacks of cement at 150 ft. Mudded hole
top and dumped 10 sacks of cement in surface pipe at base of cellar.

13 23 4W
12 3
1-3-41

(If additional description is necessary, use BACK of this sheet)

Correspondence regarding this well should be addressed to SA. KEEFOVER
Address P.O. Box R Burrton, Kansas

STATE OF KANSAS, COUNTY OF RENO, SS.
J. M. Green (employee of owner) or (owner) of the above-described well,

being first duly sworn on oath, says: That I have knowledge of the facts, statements, and matters herein contained and the log of the above-described well as filed and that the same are true and correct. So help me God.

(Signature) J. M. Green

(Address)

SUBSCRIBED AND SWORN to before me this 29 day of December, 19 41

G. J. Bryant
Notary Public.

My commission expires 4/30/42

15-155-02517-0000

OLSON OIL COMPANY
M. E. SABIN "B" # 4
C SE SW 13-23S-4W
RENO COUNTY, KANSAS

COMMENCED 6-19-36
COMPLETED 7-17-36
ELEVATION


0
 24 Sand
 250 Sand & shale
 327 Lime shells
 350 Shale & sand
 481 Salt
 620 Anhydrite
 680 Shale & shells
 710 " "
 782 Broken lime & sh
 879 Lime & shale
 964 Shale & shells
 1027 Lime & shale
 1101 Broken lime
 30 Broken lime & shale
 75 Shale & shells
 89 Lime shells
 1260 Broken shale
 1346 Broken lime & shale
 54 Red rock
 1519 Shale
 31 Red rock
 70 Shale
 1733 Shale & shells
 1817 Shale
 65 Broken shale
 1902 Broken lime & shale
 2014 Shale
 44 Lime
 64 Broken lime
 2100 Lime & shale
 90 Broken lime & shale
 2267 Broken shale
 2331 Broken lime
 2417 Lime
 54 Broken shale
 2501 Sand
 2523 Lime & sand
 32 Broken shale
 52 Lime

2621 Shale & shells
 90 Broken lime
 2704 Lime, soft
 12 Lime, hard
 2832 Lime
 54 Shale
 2951 Lime
 3014 Broken lime
 3051 Shale
 65 Lime, hard
 75 Broken lime
 3115 Shale & shells
 30 Shale
 50 Broken lime
 57 Shale
 93 Shale
 3248 Shale, Var.
 52 Lime
 3275 Chat
 3324 Chat, 4,000 M gas
 37 Chat, first oil
 74 Chat, 8,000 M gas
 TOTAL DEPTH

CASING RECORD

13"	O.D.	40#	L.W.	251
7 "	O.D.	22#	S.S.	3266

LOG
 FILE 13 23R 4W
 BOOK PAGE 12 LINE 3

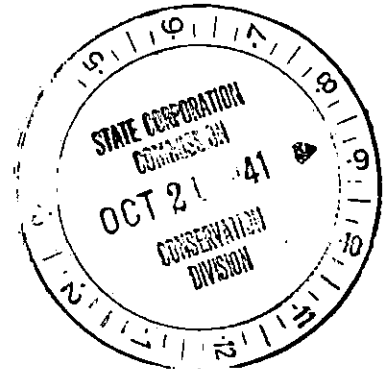

Subscribed and sworn to before me
this 20th day of October, 1941.

J. J. Bryant
 Notary Public

I hereby certify that the above is
 a true and correct copy of the log of
 M. E. Sabin "B" # 4, C SE SW,
 Sec. 13-23S-4W, Reno County, Kansas

S. A. Keefover
 13