


WELL PLUGGING RECORD

Give All Information Completely
Make Required Affidavit
Mail or Deliver Report to:
Conservation Division
State Corporation Commission
800 Bitting Building
Wichita, Kansas

Reno County. Sec. 13 Twp. 23 Rge. 20 1/4 (W)
Location as "NE/CNW 1/4 SW 1/4" or footage from lines C. E. 1/2 E. 1/2 NE 1/4
Lease Owner Cooperative Refinery Association
Lease Name Sabin Well No. 3
Office Address 914 Central Bldg., Wichita, Kansas
Character of Well (completed as Oil, Gas or Dry Hole) oil
Date well completed Aug. 22 1940
Application for plugging filed April 25 1951
Application for plugging approved April 26 1951
Plugging commenced May 12 1951
Plugging completed May 19 1951
Reason for abandonment of well or producing formation Casing collapsed

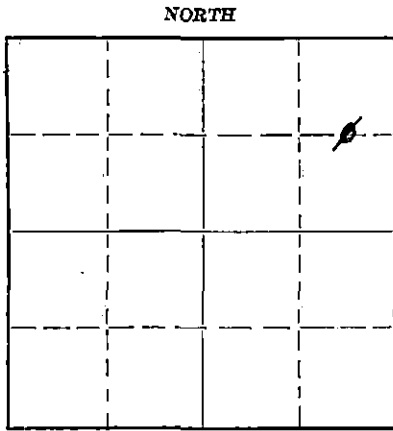

Locate well correctly on above Section Plat

If a producing well is abandoned, date of last production April 21 1951
Was permission obtained from the Conservation Division or its agents before plugging was commenced? YES

Name of Conservation Agent who supervised plugging of this well Ruel Durkee
Producing formation Mississippian Depth to top 3325 Bottom 3393 Total Depth of Well 3393 Feet
Show depth and thickness of all water, oil and gas formations.

OIL, GAS OR WATER RECORDS

CASING RECORD

Formation	Content	From	To	Size	Put In	Pulled Out
				12 1/2"	255'	00
				4-1/2"	3321'	2007'

Describe in detail the manner in which the well was plugged, indicating where the mud fluid was placed and the method or methods used in introducing it into the hole. If cement or other plugs were used, state the character of same and depth placed, from _____ feet to _____ feet for each plug set.

Pumped 20 sacks cement down 2" tubing to bottom of hole with Halliburton.
Shot off 2" tubing and 4-1/2" casing at 2000'. Pulled both strings.
Mudded hole to 220' where fresh water plug was set with 10' rock. Dumped 20 sacks cement on rock. Filled hole with mud to within 15' of surface. Rock and 10 sacks cement to bottom of cellar.

RECEIVED
STATE CORPORATION COMMISSION

MAY 25 1951 5-25-51

CONSERVATION DIVISION
Wichita, Kansas

(If additional description is necessary, use BACK of this sheet)

Correspondence regarding this well should be addressed to Cooperative Refinery Association
Address 914 Central Bldg., Wichita 2, Kansas

STATE OF Kansas, COUNTY OF Sedgwick, ss.
O.W. Gosnell (employee of owner) or (owner) of the above-described well,
being first duly sworn on oath, says: That I have knowledge of the facts, statements, and matters herein contained and the log of the above-described well as filed and that the same are true and correct. So help me God.

(Signature) O.W. Gosnell
914 Central Bldg., Wichita 2, Kansas (Address)

SUBSCRIBED AND SWORN to before me this 24 day of May, 1951.
Ruth V. Love Notary Public.

My commission expires Mar. 5, 1953.

PLUGGING
FILE SEC 13 T 23 R 14 W
BOOK PAGE 77 LINE 38

Burton Pool Ring E of Kansas

Drilling Sabin #3 Commenced 7-29-40, Completed 8-22-40

Drilled in the E $\frac{1}{2}$ of the N.E. $\frac{1}{4}$ of Sec. 13-23-4 West

14/7/41

C E $\frac{1}{2}$ E $\frac{1}{2}$ NE 1

From	To	Formation			
-	255	Sand and shale	3336	3338	Lime (hard)
255	509	Sand and shale	3338	3339	Lime (hard)
509	574	Lime broken	3339	3342	Lime (oil)
574	744	Lime and shale	3342	3356	Lime (oil)
744	868	Lime and shale	3356	3364	Lime and chat
868	1010	Lime and shale	3364	3375	Lime and chat
1010	1134	Shale and shells	3375	3379	Lime and chat
1134	1210	Lime and shale	3379	3386	Lime and chat
1210	1265	Shale and shells	3386	3390	Lime (softer)
1265	1365	Lime and shale	3390	3392	Lime (soft)
1365	1452	Shale	3392	3393	Lime (hard)
1452	1625	Shale and shells	3393	- - -	Total depth
1625	1785	Sand and shale			
1785	1894	Shale and shells			
1894	1938	Shale and shells			
1938	2045	Shale and shells			
2045	2125	Shale			
2125	2203	Shale			
2203	2276	Lime and shale			
2276	2325	Lime and shale			
2325	2390	Shale			
2390	2470	Shale			
2570	2507	Shale			
2507	2562	Lime and shale			
2562	2597	Shale			
2597	2658	Shale and shells			
2658	2676	Shale and shells			
2676	2677	Lime rough			
2677	2690	Shale and shells			
2680	2730	Shale and shells			
2730	2765	Lime			
2765	2805	Lime			
2805	2850	Lime			
2850	2871	Shale			
2871	2904	Shale and shells			
2904	2934	Lime and shale			
2934	2964	Shale and lime			
2964	2982	Shale and lime			
2982	3022	Lime and shale			
3022	3098	Lime and shale			
3098	3130	Lime and shale			
3130	3144	Lime and shale			
3144	3205	Shale and broken lime			
3205	3247	Shells and shale			
3247	3255	Shale			
3255	3285	Chat			
3285	3300	Chat			
3300	3325	Chert and lime			
3325	3326	Lime			
3326	3328	Shale			
3328	3333	Shale			
3333	3336	Lime (Hard)			

Casing Record

255' of 12 $\frac{1}{2}$ " 40 lb. casing run and cemented with 125 sacks Atlas cement.
Cemented 3321' 4 $\frac{1}{2}$ " 9 $\frac{1}{2}$ lb. casing with 150 sacks Atlas cement 5' off bottom. at total depth of 3325'

12 $\frac{1}{2}$ " at 255' with 125 sacks
4 $\frac{1}{2}$ " at 3321' with 150 sacks

I.P. Initial

3340 - CC

3:15:13 T

3:15:13

3:15:13

74

Miss 3255 (1782)

4 7 5

Miss 3255

130 Miss