


15-155-02792-0000

FORM CP-4

STATE OF KANSAS
STATE CORPORATION COMMISSION
CONSERVATION DIVISION
P. O. BOX 17027
WICHITA, KANSAS 67217

WELL PLUGGING RECORD

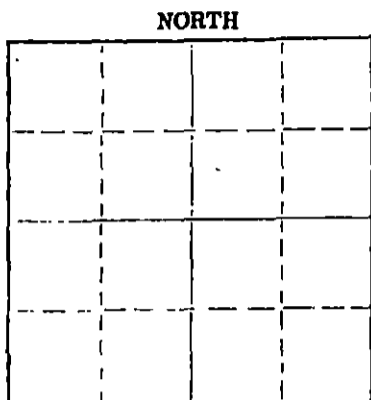

Locate well correctly on above Section Plat

Reno County, Sec 12 Twp 23 Rge 4 (E) (W) X
Location as "NE/CNW/SW" or footage from lines SE-SW-NW
Lease Owner Four-Way Operating, Inc.
Lease Name NEUFELD Well No. 4
Office Address Box 698, Great Bend, Kansas 67530
Character of Well (completed as Oil, Gas or Dry Hole)
Date well completed 19
Application for plugging filed January 5 19 76
Application for plugging approved 19
Plugging commenced January 19 19 76
Plugging completed February 20 19 76
Reason for abandonment of well or producing formation depleted

If a producing well is abandoned, date of last production 19
Was permission obtained from the Conservation Division or its agents before plugging was commenced? yes

Name of Conservation Agent who supervised plugging of this well Gilbert Toman
Producing formation Depth to top Bottom Total Depth of Well 3422 Feet
Show depth and thickness of all water, oil and gas formations.

OIL, GAS OR WATER RECORDS

CASING RECORD

FORMATION	CONTENT	FROM	TO	SIZE	PUT IN	PULLED OUT
				12 1/4"	217'	0
				10 3/4"	504'	272.88'
				6 5/8"	3420'	1,991.85'


Describe in detail the manner in which the well was plugged, indicating where the mud fluid was placed and the method or methods used in introducing it into the hole. If cement or other plugs were used, state the character of same and depth placed, from feet to feet for each plug set.

Set plug at 3,000 ft. Dumped 20 ft. sand and 6 sacks cement.
Shot pipe @ 1990 ft. Pulled a total of 69 joints of 6 5/8" casing.
Shot 10 3/4" at 264 ft. Pulled 13 joints of 10 3/4" casing (272.88')
Halliburton plugged well with 5 sacks hulls, 25 sacks gel, 100 sacks 50/50
Pozmix with 2% added gel, 15 sacks gel, 3 sacks hulls and 75 sacks cement.

Name of Plugging Contractor Rockhold Engineering, Inc. (If additional description is necessary, use BACK of this sheet)
Address Box 698, Great Bend, Kansas 67530

STATE OF Kansas COUNTY OF Barton ss. 3-29-1976
James W. Rockhold (employee of owner) or (owner or operator) of the above-described

well, being first duly sworn on oath, says: That I have knowledge of the facts, statements, and matters herein contained and the log of the above-described well as filed and that the same are true and correct. So help me God.

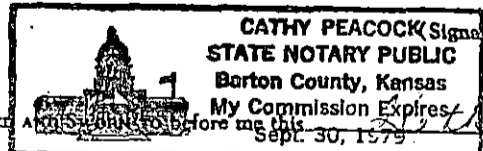

James W. Rockhold (Signature)
Box 698, Great Bend, Kansas 67530 (Address)
March 19 76
Cathy Peacock (Signature)
Cathy Peacock Notary Public.

My commission expires September 30, 1979