

15-095-21281-0000


STATE OF KANSAS
STATE CORPORATION COMMISSION
200 Colorado Derby Bldg.
Wichita, Kansas 67202

Form CP-4
Rev. 12-15-80

WELL PLUGGING RECORD

Give All Information Completely
Make Required Affidavit

COUNTY Kingman SEC. 27 TWP. 27S RGE. 10 XX/W
Location as in quarters or footage from lines:
W/2 W/2 SE/4

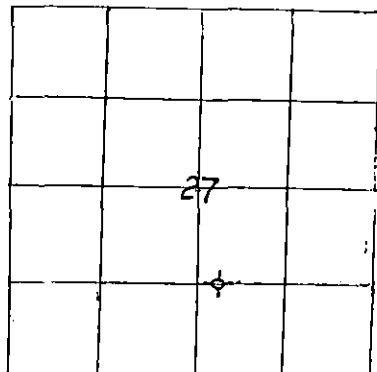

Lease Owner Texas Energies, Inc.
Lease Name Alley Well No. 1-27
Office Address P.O. Box 947 Pratt, KS 67124
Character of Well (Completed as Oil, Gas or Dry Hole): Dry Hole
Date Well Completed 10-04-82
Application for plugging filed 10-15-82
Plugging commenced 10-04-82
Plugging completed 10-04-82
Reason for abandonment of well or producing formation

Locate Well
correctly on above
Section Platt.

Dry Hole
Was permission obtained from the Conservation Division or it's
Agent's before plugging was commenced? Yes

Name of Conservation Agent who supervised plugging of this well Dan Marcotte

Producing formation -- Depth to top -- bottom -- T.D. 4474

Show depth and thickness of all water, oil and gas formations.

OIL, GAS OR WATER RECORDS

Casing Record

Formation	Content	From	To	Size	Put in	Pulled Out
				13 3/8	38	None
				8 5/8	258	None

Describe in detail the manner in which the well was plugged, indicating where the mud fluid was placed and the method or methods used in introducing it into the hold. If cement or other plugs were used, state the character of same and depth placed, from feet to feet for each plug set.


Plugged well with 140 sxs 50-50 poz mix 2% Gel
as follows:
cement plug at 800' with 50 sxs
cement plug at 400' with 30 sxs
cement plug at 280' with 35 sxs
wood plug and 1 sx hulls at 60' and filled to top with 10 sxs
rathole with 10 sxs
water well with 5 sxs

(If additional description is necessary, use BACK of this sheet)

Name of Plugging Contractor Wheatstate Drilling

STATE OF Kansas COUNTY OF Pratt, ss.
E. H. Bittner (employee of owner) or ~~owner or operator~~ of the
above-described well, being first duly sworn on oath, says: That I have knowledge of the
facts, statements, and matters herein contained and the log of the above-described well as
filed and that the same are true and correct. So help me God.

(Signature) E H Bittner
P.O. Box 947 Pratt, KS 67124
(Address)

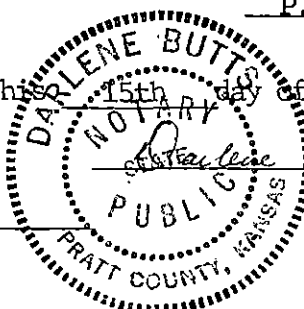

15th day of October, 1982
Butts
Notary Public.

RECEIVED
STATE CORPORATION COMMISSION
OCT 22 1982
CONSERVATION DIVISION
Wichita, Kansas
My Commission expires: April 23, 1983