

15-095-00049-00-00


STATE OF KANSAS  
STATE CORPORATION COMMISSION

WELL PLUGGING RECORD

Give All Information Completely  
Make Required Affidavit  
Mail or Deliver Report to:  
Conservation Division  
State Corporation Commission  
211 No. Broadway  
Wichita, Kansas

Kingman County, Sec. 33 Twp. 27 Rge. 10 XK W (W)  
Location as "NE/CNW/SW" or footage from lines C NW NW SE  
Lease Owner Graybol Oil Corporation  
Lease Name Huffman "A" Well No. 1  
Office Address 2200 National Bank of Tulsa Bldg., Tulsa, Okla.  
Character of Well (completed as Oil, Gas or Dry Hole) Dry Hole  
Date well completed November 28, 1961 19 61  
Application for plugging filed November 30 19 61  
Application for plugging approved November 28 19 61  
Plugging commenced November 28 19 61  
Plugging completed November 28, 1961 19 61  
Reason for abandonment of well or producing formation Dry Hole

NORTH

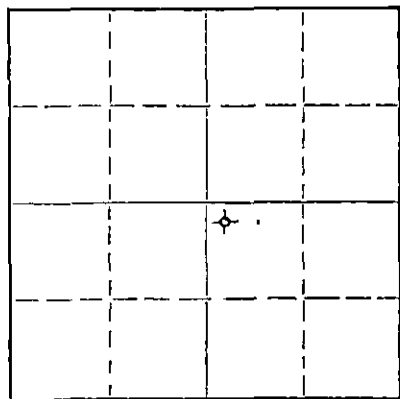

Locate well correctly on above  
Section Plat

If a producing well is abandoned, date of last production \_\_\_\_\_ 19\_\_\_\_  
Was permission obtained from the Conservation Division or its agents before plugging was commenced? Yes

Name of Conservation Agent who supervised plugging of this well Fred Hampel  
Producing formation None Depth to top \_\_\_\_\_ Bottom \_\_\_\_\_ Total Depth of Well 4398 Feet  
Show depth and thickness of all water, oil and gas formations.

OIL, GAS OR WATER RECORDS

CASING RECORD

FORMATION	CONTENT	FROM	TO	SIZE	PUT IN	PULLED OUT
				8 5/8"	260	None
Miss. Chert	Saltwater	4014	4076			
Viola	Saltwater	4298	4377			
Simpson Sand	Saltwater	4388	4398			

Describe in detail the manner in which the well was plugged, indicating where the mud fluid was placed and the method or methods used in introducing it into the hole. If cement or other plugs were used, state the character of same and depth placed, from \_\_\_\_\_ feet to \_\_\_\_\_ feet for each plug set.

Filled hole with heavy mud. Spotted 20 sacks regular cement @ 240'. Spotted 10 sacks cement @ 35'. Spotted 2 sacks cement in rat hole.

RECEIVED  
CONSERVATION DIVISION  
Wichita, Kansas  
12-07-61

(If additional description is necessary, use BACK of this sheet)

Name of Plugging Contractor Graybol Oil Corporation  
Address above

STATE OF OKLAHOMA COUNTY OF Tulsa, ss.  
Edward Haddad (employee of owner) or (~~owner or operator~~) of the above-described well, being first duly sworn on oath, says: That I have knowledge of the facts, statements, and matters herein contained and the log of the above-described well as filed and that the same are true and correct. So help me God.

(Signature) Edward Haddad  
2200 N.B.T. Bldg., Tulsa, Oklahoma  
(Address)

SUBSCRIBED AND SWORN TO before me this 5th day of December 19 61

My commission expires October 8, 1962

Jim Lawhorn  
Notary Public.



Graybol Oil Corporation

Kingman County, Kansas

15-095-00049-0000

No. 1 Huffman "A" NW NW SE

Section 33-27S-10W

Contractor: Company Tools

Elev: G.L. 1686', D.F. 1692'  
K.B. 1692'

Commenced: November 12, 1961

Completed: November 28, 1961

Production: Dry and Abandoned

CASING RECORD

Set 260' 8 5/8" surface casing cemented with 225 sacks.

Depth	Formation	FORMATION TOPS: (Electric Log)
0-105	River Sand	Heebner Shale 3317
105-230	Red shale and shells.	Brown Lime 3496
230-265	Sand and red bed.	Lansing 3521
265-790	Red Shale.	Base/KC 3900
790-1338	Shale, red beds with lime streaks.	Miss. Chert 4014
1338-1525	Red beds, sand and lime streaks.	Kinderhook 4087
1525-1626	Lime	Viola 4298 ✓
1626-1789	Shaly sandy lime.	Simpson Shale 4377
1789-1995	Lime	Simpson Sand 4388
1995-2115	Shaly lime.	
2115-2200	Shale and lime streaks.	
2200-2400	Lime and Shale	
2400-3030	Shale and lime.	
3030-3095	Shaley lime.	
3095-3215	Sandy lime with shale.	
3215-3330	Sand, lime, and shale.	
3330-3489	Shale and lime.	
3489-3557	Lime and shale, sandy.	
3557-3649	Lime.	
3649-3687	Lime and shale.	
3687-3711	Lime	
3711-3770	Lime with shale.	
3770-3805	Lime and shale.	
3805-3836	Lime	
3836-3930	Lime and shale.	
3930-3974	Lime	
3974-4016	Shale and lime.	
4016-4025	Chat	
4025-4030	Chat	
4030-4070	Chert	
4070-4081	Shale, chert, and lime.	
4081-4096	Shale and lime.	
4096-4164	Chert, lime, and shale.	
4164-4333	Shale and lime.	
4333-4361	Lime.	
4361-4383	Shale with lime.	
4383-4391	Lime	
4391-4392	Sand.	
Drillers T.D. 4392'	Welex T.D. 4398'	

Drill Stem Tests

No. 1 4017-30 Open 1 1/2 hours.  
 Rec. 180' slightly oil spotted drilling mud.  
 120' sh. oil spotted & gassy muddy saltwater.  
 60' muddy saltwater.  
 F.B.H.P. 1055/20 min.

No. 2 4295-4310 Open 1 hour.  
 240' gas in drill pipe above fluid. 420' slightly oil & gas cut mud. 1140' slightly oil & gas cut muddy saltwater. 1115' very slightly oil and gas cut saltwater.  
 F.B.H.P. 1205/20 min.

No. 3 4377-92 Open 2 hours.  
 Rec. 420' muddy saltwater and 1900' saltwater.  
 F.B.H.P. 1525/20 min.

I hereby certify that the above is a true and correct log of the above captioned well as taken directly from the daily drilling reports.

GRAYBOL OIL CORPORATION

By Edward Haddad  
Edward Haddad, Geologist

STATE OF OKLAHOMA  
County of Tulsa

Subscribed and sworn to before me this 6<sup>th</sup> day of December, 1961.

My commission expires Oct 8, 1962