


STATE OF KANSAS  
STATE CORPORATION COMMISSION

WELL PLUGGING RECORD

Give All Information Completely  
Make Required Affidavit  
Mail or Deliver Report to  
Conservation Division  
State Corporation Comm.  
245 North Water  
Wichita, KS 67202

Kingman County, Sec. 35 Twp. 27S Rge. 10 E/W  
Location as "NE/CNW $\frac{1}{4}$ /SW $\frac{1}{4}$ " or footage from lines  
1440'FNL & 870'FEL  
Lease Owner Loil Corporation  
Lease Name Baber Well No. 1  
Office Address Barrister Bldg., 1535 Grant St., Ste. 270  
Character of Well (Completed as Oil, Gas or Dry Hole) Denver  
dry hole Colo 80203  
Date Well completed 1-14 1980  
Application for plugging filed 1-14 1980  
Application for plugging approved 1-14 1980  
Plugging commenced 1-14 1980  
Plugging completed 1-14 1980  
Reason for abandonment of well or producing formation  
no commercial quantity of oil or gas encountered  
If a producing well is abandoned, date of last production  
-- 19

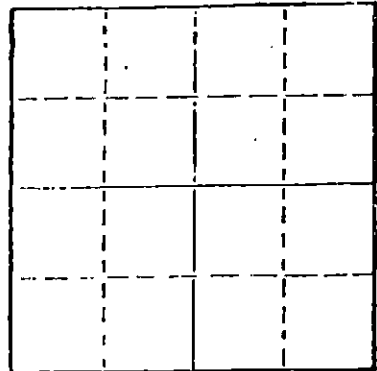

Locate well correctly on above  
Section Plot

Was permission obtained from the Conservation Division or  
its agents before plugging was commenced? yes

Name of Conservation Agent who supervised plugging of this well William T. Owen  
Producing formation \_\_\_\_\_ Depth to top \_\_\_\_\_ Bottom \_\_\_\_\_ Total Depth of Well 4465  
Show depth and thickness of all water, oil and gas formations.

OIL, GAS OR WATER RECORDS

CASING RECORD

FORMATION	CONTENT	FROM	TO	SIZE	PUT IN	PULLED OUT
surface hole	shale	surf	245'	8-5/8"	243'	none

Describe in detail the manner in which the well was plugged, indicating where the mud fluid  
was placed and the method or methods used in introducing it into the hold. If cement or other  
plugs were used, state the character of same and depth placed, from \_\_\_\_\_ feet to  
\_\_\_\_\_ feet for each plug set.

Fluid to 240', plug, 40 sx  
Fluid to 40', plug, 10 sx  
Rat hole 5 sx

RECEIVED  
STATE CORPORATION COMMISSION  
JAN 30 1980  
CONSERVATION DIVISION  
Wichita, Kansas

(If additional description is necessary, use BACK of this sheet)

Name of Plugging Contractor D N B DRILLING, INC.  
515 R. H. Garvey Building  
Wichita, Kansas 67202

STATE OF Kansas COUNTY OF Sedgwick, ss.  
Ella Priess (employee of owner) or (owner or operator)

of the above-described well, being first duly sworn on oath, says: That I have knowledge of  
the facts, statements, and matters herein contained and the log of the above-described well  
as filed and that the same are true and correct. So help me God.

(Signature) Ella Priess

Suite 515, R.H. Garvey Bldg., Wichita, Ks.  
(Address) 67202

SUBSCRIBED AND SWORN TO before me this 17th day of January, 19 80

Dorothy L. Schmidt  
Dorothy L. Schmidt Notary Public.

My commission expires April 30, 1983

DOROTHY L. SCHMIDT  
STATE NOTARY PUBLIC  
Sedgwick County, Kansas  
My Appt. Exp. April 30, 1983

15-095-20906-0000

DRILLER'S LOG

LOIL CORPORATION  
No. 1 Baber  
1440' FNL & 870' FEL  
Sec. 35-27S-10W  
Kingman Co., Ks.

Commenced: 1-1-80  
Completed: 1-14-80

Surface Casing: 243' of 3-5/8"  
cemented w/225 sx common

FORMATION

DEPTH

Surface Hole	0 - 245
Shale & Sand	245 - 353
Sand & Shale	353 - 1477
Shale & Sand	1477 - 1741
Lime & Shale	1741 - 3125
Sand & Shale	3125 - 3180
Lime & Shale	3180 - 3975
Lime & Chert	3975 - 3982
Lime	3982 - 4164
Lime & Shale	4164 - 4327
Lime	4327 - 4418
Sand	4418 - 4428
Lime & Chert	4428 - 4465 RTD

I do hereby certify that the foregoing statements are true and correct to the best of my knowledge and belief.

D N B DRILLING, INC.

*Ella Priess*

Ella Priess

STATE OF KANSAS: ss:

Subscribed and sworn to before me this 17th day of January, 1980.

RECEIVED  
STATE CORPORATION COMMISSION

JAN 30 1980

CONSERVATION DIVISION  
Wichita, Kansas

*Dorothy L. Schmidt*

Dorothy L. Schmidt, Notary Public

DOROTHY L. SCHMIDT  
STATE NOTARY PUBLIC  
Sedgwick County, Kansas  
My Appt. Exp. April 30, 1983