


STATE OF KANSAS
STATE CORPORATION COMMISSION

Give All Information Completely
Make Required Affidavit
Mail or Deliver Report to:
Conservation Division
State Corporation Commission
212 No. Market
Wichita, Kansas

WELL PLUGGING RECORD

NORTH

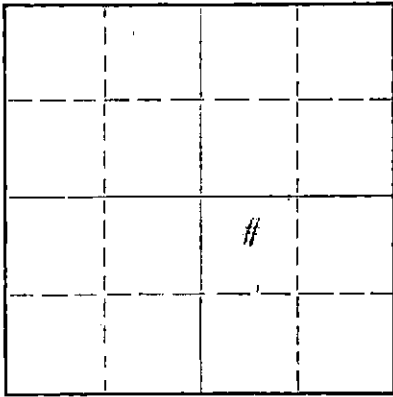

Locate well correctly on above
Section Plat

Kingman County. Sec. 1 Twp. 28 Rge. 5 (E) W (W)
Location as "NE/CNW/SE" or footage from lines CNW/SE
Lease Owner Martin & Keller
Lease Name Baxter Well No. 1
Office Address 1430 Terrace Drive Tulsa, Okla.
Character of Well (completed as Oil, Gas or Dry Hole) Gas
Date well completed Dec. 27, 1964
Application for plugging filed 19
Application for plugging approved 19
Plugging commenced Dec. 24, 1968
Plugging completed Dec. 26, 1968
Reason for abandonment of well or producing formation _____

If a producing well is abandoned, date of last production 19
Was permission obtained from the Conservation Division or its agents before plugging was commenced? Yes

Name of Conservation Agent who supervised plugging of this well Ralph Warren
Producing formation _____ Depth to top _____ Bottom _____ Total Depth of Well _____ Feet
Show depth and thickness of all water, oil and gas formations.

OIL, GAS OR WATER RECORDS

CASING RECORD

FORMATION	CONTENT	FROM	TO	SIZE	PUT IN	PULLED OUT
				8 5/8	211'	None
				5 1/2	1691'	1301'

Describe in detail the manner in which the well was plugged, indicating where the mud fluid was placed and the method or methods used in introducing it into the hole. If cement or other plugs were used, state the character of same and depth placed, from _____ feet to _____ feet for each plug set.

Plugged back with sand from 1700' to 1680'. Mixed and dumped 5 ex. of cement from 1680' to 1640'. Pulled casing. Mudded hole to 210'. Set 10' rock bridge from 210' to 200'. Mixed and dumped 25 ex. of cement from 200' to 125'. Mudded hole from 125' to 40'. Set 10' rock bridge from 40' to 30'. Mixed and dumped 10 ex. of cement from 30' to base of the cellar.

RECEIVED
STATE CORPORATION COMMISSION
JAN 14 1969
CONSERVATION DIVISION
Wichita, Kansas

(If additional description is necessary, use BACK of this sheet)

Name of Plugging Contractor Russ Casing Pulling Inc.
Address Box 1082 Great Bend, Ks. 67530

STATE OF OKLAHOMA, COUNTY OF TULSA, ss.
Cecil M. Keller (owner or town operator) of the above-described

well, being first duly sworn on oath, says: That I have knowledge of the facts, statements, and matters herein contained and the log of the above-described well as filed and that the same are true and correct. So help me God.

(Signature) Cecil M. Keller
Cecil M. Keller
1430 Terrace Drive, Tulsa, Okla. 74104
(Address)

SUBSCRIBED AND SWORN TO before me this 10th day of January, 19 69

My commission expires April 21, 1971
Aldine Qualls
Aldine Qualls - Notary Public.

1509530006000

RECEIVED
STATE CORPORATION COMMISSION
DEC 13 1968
CONSERVATION DIVISION
Wichita, Kansas

DRILLER'S LOG

COMPANY:
CONTRACTOR:
FIRM:
LOCATION:

Marlin & Keller
LEBAN DRILLING, INC.
BOSTON, MO
C W. SE Sec. 7-225-34
KINGMAN COUNTY, KANSAS
11-21-64
11-17-64

COMMENCED:
COMPLETED:

0	0.0	Redbed
2.1	5.5	Shale
3.5	10.0	Shale & Lime
10.60	14.4	Lime
14.14	16.90	Shale & Lime
15.90	17.00	Shale & Sand
	17.00	<u>Rotary Total Depth - Sec 5 1/2'</u> Casing

Sec 5 1/2' used surface casing 1" cemented with 175 sacks 60-40
Pozzolan GLS

I, Leslie Kite, do hereby certify that the above and foregoing is a true and correct copy of the log of the Boston, Mo well, located C W. SE of Section 7, Township 28 South, Range 3 West, Kingman County, Kansas, as reflected by the files of Leban Drilling, Inc.

Leslie Kite
Leslie Kite

STATE OF KANSAS)
) SS
COUNTY OF BARTON)

Subscribed and sworn to before me, a Notary Public, in and for Barton County, Kansas, this 9th day of December, 1964.

Wanda Nichols
Wanda Nichols

My Commission Expires
April 1, 1967