


STATE OF KANSAS
STATE CORPORATION COMMISSION

Give All Information Completely
Make Required Affidavit
Mail or Deliver Report to:
Conservation Division
State Corporation Commission
212 No. Market
Wichita, Kansas

WELL PLUGGING RECORD

Kingman County, Sec. 1 Twp. 28S Rge. 5 (E) (W) X
Location as "NE/CNW/SW" or footage from lines SW NE SW

Lease Owner Martin & Keller
Lease Name Casley Well No. 1
Office Address 1430 Terrace Tulsa, Oklahoma 74104
Character of Well (completed as Oil, Gas or Dry Hole)
Date well completed 19
Application for plugging filed 2-20-68 19
Application for plugging approved 2-21-68 19
Plugging commenced 2-26-68 19
Plugging completed 2-28-68 19
Reason for abandonment of well or producing formation

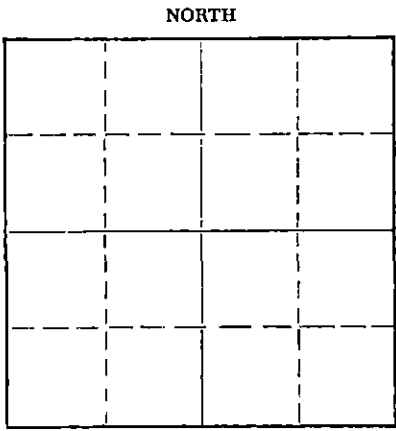

Locate well correctly on above Section Flat

If a producing well is abandoned, date of last production 19
Was permission obtained from the Conservation Division or its agents before plugging was commenced? Yes

Name of Conservation Agent who supervised plugging of this well Archie V. Elving
Producing formation Depth to top Bottom Total Depth of Well 1700 Feet
Show depth and thickness of all water, oil and gas formations.

OIL, GAS OR WATER RECORDS

CASING RECORD

FORMATION	CONTENT	FROM	TO	SIZE	PUT IN	PULLED OUT
				8 5/8	205	None
				5 1/2	None	1148
RECEIVED STATE CORPORATION COMMISSION MAR 6 - 1968 CONSERVATION DIVISION Wichita, Kansas						

Describe in detail the manner in which the well was plugged, indicating where the mud fluid was placed and the method or methods used in introducing it into the hole. If cement or other plugs were used, state the character of same and depth placed, from feet to feet for each plug set.

Moved in. Cleaned out cellar. Sanded to 1650'. Dumped 5 sacks of cement.

Rigged up. Working pipe. Shot pipe at 1300'. Mud came in. Shot pipe at 1150'. Pulling pipe.

Plugging well. Set rock bridge at 200'. Dumped 25 sacks of cement. Mudded to 40' rock bridge. Capped well with 10 sacks of cement.

(If additional description is necessary, use BACK of this sheet)

Name of Plugging Contractor Forbes Casing Pulling, Inc.
Address P. O. Box 221 Great Bend, Kansas 67530

STATE OF Kansas, COUNTY OF Barton, ss.
J. O. Forbes (employee of owner) or (owner or operator) of the above-described well, being first duly sworn on oath, says: That I have knowledge of the facts, statements, and matters herein contained and the log of the above-described well as filed and that the same are true and correct. So help me God.

(Signature) J. O. Forbes
P. O. Box 221 Great Bend, Kansas (Address)

SUBSCRIBED AND SWORN TO before me this 4 day of March, 19 68

My commission expires May 27, 1969

Notary Public.

15095-01858-0000

Casing Record

8 5/8 205' Cemented
w/150 sacks

5 1/2 1689' Cemented
w/50 sacks

T. D. 1700'

Location: SW NE SW
Section: 1-28S-5W
Kingman County, Kansas
Farm: Casley #1
Well Owner: Martin & Keller
Contractor: White & Ellis
Drilling, Inc.
Started: 4-8-64
Completed: 4-12-64

Kelly Bushing Measurement 5' above ground level.

FORMATION	DEPTH
Sand & Red Rock	0-80
Shale & Red Rock	130
Shale & Lime stks.	285
Shale & Red Rock	360
Shale	500
Shale & Anhydrite	720
Anhydrite	720
Lime & Shale	920
Lime & Shale stks.	967
Lime	998
Lime & Shale (stks.)	1207
Lime & Shale	1307
Shale & Lime stks.	1680
Sand & Shale	1700

TOPS

Anhydrite 720

RECEIVED
STATE CORPORATION COMMISSION
FEB 21 1968
CONSERVATION DIVISION
Wichita, Kansas