


WELL PLUGGING RECORD

Give All Information Completely
Make Required Affidavit
Mail or Deliver Report to:
Conservation Division
State Corporation Commission
211 No. Broadway
Wichita, Kansas

Kingman County, Sec. 2 Twp. 28 Rge. (E) 5 (W)
Location as "NE/CNW/SW" or footage from lines SE SW SE
Lease Owner McAdams Pipe & Supply Company
Lease Name Richey Well No. 1
Office Address P.O. Drawer 960, Bristow, Oklahoma
Character of Well (completed as Oil, Gas or Dry Hole) dry hole
Date well completed 19
Application for plugging filed June 9 19 65
Application for plugging approved 19
Plugging commenced June 11 19 65
Plugging completed June 16 19 65
Reason for abandonment of well or producing formation dry hole

NORTH

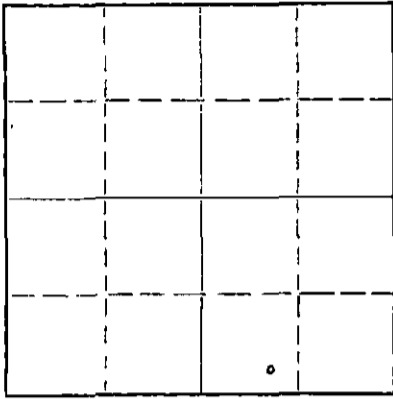

Locate well correctly on above Section Plat

If a producing well is abandoned, date of last production 19
Was permission obtained from the Conservation Division or its agents before plugging was commenced? yes

Name of Conservation Agent who supervised plugging of this well Archie Elving
Producing formation Depth to top Bottom Total Depth of Well 3814 Feet
Show depth and thickness of all water, oil and gas formations.

OIL, GAS OR WATER RECORDS

CASING RECORD

FORMATION	CONTENT	FROM	TO	SIZE	PUT IN	PULLED OUT
		0	163'	8 5/8"	163'	none
		0	3814'	5 1/2"	3814'	3031.60

Describe in detail the manner in which the well was plugged, indicating where the mud fluid was placed and the method or methods used in introducing it into the hole. If cement or other plugs were used, state the character of same and depth placed, from feet to feet for each plug set.

Pushed plug to 3760', set 10' rock bridge and dumped 5 sacks of cement.

Filled hole with dirt and sand to 200'. Dumped 27 sacks of cement.
Filled hole with dirt and sand to 30' and capped hole with 10 sacks of cement.

RECEIVED
STATE CORPORATION COMMISSION

JUL 19 1965

CONSERVATION DIVISION
Wichita, Kansas

(If additional description is necessary, use BACK of this sheet)

Name of Plugging Contractor Pipe Pullers, Inc.
Address Box 486, Ellinwood, Kansas

STATE OF Kansas, COUNTY OF Barton, ss.
Dean Wells (employee of owner) or (owner-or-operator) of the above-described well, being first duly sworn on oath, says: That I have knowledge of the facts, statements, and matters herein contained and the log of the above-described well as filed and that the same are true and correct. So help me God.

(Signature) *Dean Wells*
Ellinwood, Kansas (Address)

SUBSCRIBED AND SWORN TO before me this 18th day of June, 1965

My commission expires July 7, 1968 Notary Public.

Bennett & Roberts Drilling Co.
Richey #1

SE SW SE Sec. 2 Twp. 28 Rge. 5W
Kingman County, Kansas

RTD 3814
PBID 3782

Tops: Mississippi 3745(-2339)

Comms 8/14/54
Comp: 9/4/54

Elev: 1406DEF

Set 8 5/8" Csg. @ 163'
Set 5 1/2" Csg. @ 3814'

Formation:	Depth:
Clay, Shale & Red Bed	163'
Shale & Shells	640
Anhydrite, Lime	650
Lime, Shells & Shale	1110
Lime & Shale	1670
Shale, Lime Stracks	1935
Shale & Lime, Broken	2090
Shale & Lime streaks	2220
Lime & Shale	2475
Shale & Lime streaks	2615
Lime & Shale	3212
Lime	3255
Shale & Lime	3296
Lime	3600
Lime & Shale	3660
Lime	3701
Lime & Shale	3720
Shale	3725
Lime	3765
Shale	3768
White Chalky Dolomite & Chert	3786
White Chalky Dolomite & Chert	3814

RECEIVED
STATE CORPORATION COMMISSION

JUN 10 1965

CONSERVATION DIVISION
Wichita, Kansas

STATE OF KANSAS)
COUNTY OF RUSSELL) SS,

I hereby certify that the above information is correct to the best of my knowledge.

BENNETT & ROBERTS DRILLING CO.

By *David Lake*

Subscribed and sworn to before me this 7th day of September, 1954.

Clara Hummel
Notary Public



My commission expires 6/17/58