


15095-01469-0000

WELL PLUGGING RECORD

Give All Information Completely
Make Required Affidavit
Mail or Deliver Report to:
Conservation Division
State Corporation Commission
800 Bittling Building
Wichita, Kansas

NORTH

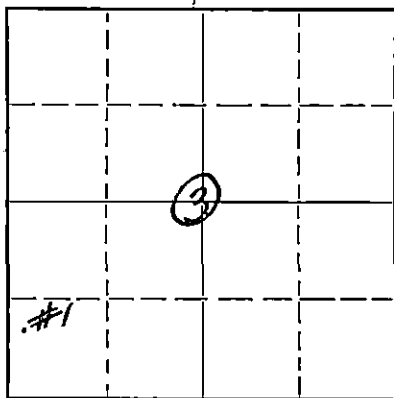

Locate well correctly on above Section Plat

Kingman County. Sec. 3 Twp. 28S Rge. 5 (W)
Location as "NE/CNW $\frac{1}{4}$ SW $\frac{1}{4}$ " or footage from lines 990'N 330'E of SW corner
Lease Owner Cities Service Oil Company
Lease Name Young B Well No. #1
Office Address Bartlesville, Oklahoma
Character of Well (completed as Oil, Gas or Dry Hole) Dry Hole
Date well completed April 10, 1951
Application for plugging filed April 13, 1951
Application for plugging approved April 14, 1951
Plugging commenced April 10, 1951
Plugging completed April 10, 1951
Reason for abandonment of well or producing formation Dry hole

If a producing well is abandoned, date of last production 19
Was permission obtained from the Conservation Division or its agents before plugging was commenced? yes

Name of Conservation Agent who supervised plugging of this well D. L. Lilley
Producing formation Mississippi Lime Depth to top Bottom Total Depth of Well 3892 Feet
Show depth and thickness of all water, oil and gas formations.

OIL, GAS OR WATER RECORDS

CASING RECORD

Formation	Content	From	To	Size	Put In	Pulled Out
				8 5/8	182'	Left in

Describe in detail the manner in which the well was plugged, indicating where the mud fluid was placed and the method or methods used in introducing it into the hole. If cement or other plugs were used, state the character of same and depth placed, from feet to feet for each plug set.

Filled hole with Rotary mud to 190'
Set wood bridge plug at 190' pumped in
15 sacks cement. Mud to 17' and set wood
bridge plug at 17' and cemented with 2 sacks
cement to 7' bottom of cellar. Filled cellar
with dirt to surface.

(If additional description is necessary, use BACK of this sheet)

Correspondence regarding this well should be addressed to
Address

STATE OF Kansas, COUNTY OF Butler, ss.
V. H. Hughey (employee of owner) or (owner or operator) of the above-described well,
being first duly sworn on oath, says: That I have knowledge of the facts, statements, and matters herein contained and the log of the above-described well as filed and that the same are true and correct. So help me God.

(Signature) V. H. Hughey
Oil Hill, Kansas (Address)

SUBSCRIBED AND SWORN TO before me this 17th day of April 19 51

My commission expires June 6, 1951

[Signature]
Notary Public.

28-5091-s 8-50-10M

APR 19 1951 04-19-51

CONSERVATION DIVISION
Wichita, Kansas

PLUGGING
FILE SEC 3 T 28 R 5W
BOOK PAGE 73 LINE 34

15095 01469-0000

Cities Service Oil Co.,

Sec. 3-28-5W,
Kingman Co., Kansas.

Young #1-B

Drig. Comm: 3-27-51
Drig. Comp: 4-10-51
Drld. By: Barbour Drilling Co.

Loc: 990'N, 330'E of SW Corner
Elev: 1429' R.T.B.
Note: All measurements taken from R.T.B.

T.D. 3892'

R.T.D. 3892'

I.P. Dry Hole

Steel Line Measurement:

Casing Record:
8 5/8" set at 191'; cem. w/ 125' sax.
No oil string run

500=500
1000=1000
1600=1600
2000=2000
2500=2500
2807=2807
3500=3500

Straight Hole Survey: (Syfo)

500' O.K.
1000' O.K.
1500' O.K.
2000' O.K.
2500' O.K.
3000' O.K.
3500' O.K.

Top Brown Ls. 2949' (-1520) N.S.O.
Base 2954'

Top Lansing Ls. 2979'
N.S.O. to 3135'
3213-38 V.S.S.O. (lt. stain)
3248-55 V.S.S.O. (lt. stain)
Base 3425'

Formation Record:

Depth:

clay & sand	0- 65
shale & sand	100
shale	191
shale & shells	865
anhydrite	890
shale	950
salt & shale	1115
shale & lime	1420
shale & shells	1910
shale	2090
shale & shells	2405
shale	2600
lime	2685
lime & shale	2775
shale	2995
lime & shale	3210
lime	3350
lime & shale	3525
lime	3580
lime & shale	3650
shale & shells	3690
lime	3697
shale & lime	3747
shale & shells	3780
lime (Miss.)	3818
chert & lime	3839
lime	3875
chat	3892

Top Miss. Chert 3777'
3777-89 N.S.O.
3789-98 very rare stain in chert
3798-3826 N.S.O.
3826-39 N.S.O.
3839-46 chert is lightly stained, no free oil.

D.S.T. #1 3786-46 60' anchor, packer set at 3786
Open 45 min., sli. blow throughout
Closed 12 min., B.H.P. 65#
Results: 25' gas cut mud, no gas in stand,
no odor oil or gas, no free oil or scum, some
bubbles in mud in tester.

3846-54 N.S.O.
3854-92 N.S.O.
R.T.D. 3892'

D. & A.

T.D. 3892'

4-13-51
mj

RECEIVED
STATE CORPORATION COMMISSION

APR 14 1951

CONSERVATION DIVISION

PLUGGING
FILE SEC-2 T-28 R-5W
BOOK PAGE 73 LINE 34