

15-095-20775-000

FORM CP-4


STATE OF KANSAS
STATE CORPORATION COMMISSION

WELL PLUGGING RECORD

Give All Information Completely
Make Required Affidavit
Mail or Deliver Report to
Conservation Division
State Corporation Comm.
245 North Water
Wichita, KS 67202

Kingman County, Sec. 4 Twp. 28S Rge. 5W E/W
Location as "NE/CNW $\frac{1}{4}$ SW $\frac{1}{4}$ " or footage from lines
C NW/4 NE/4 SE/4

Lease Owner Gear Petroleum Company
Lease Name Brown Well No. 4
Office Address 1325 Vickers KSB&T Bldg., Wichita, Ks. 67202
Character of Well (Completed as Oil, Gas or Dry Hole) _____

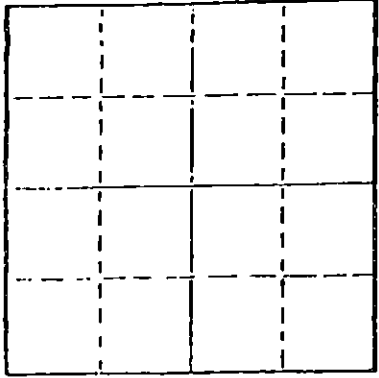

Locate well correctly on above
Section Plat

D & A
Date Well completed November 14, 1978
Application for plugging filed November 14, 1978
Application for plugging approved November 14, 1978
Plugging commenced November 14, 1978
Plugging completed November 14, 1978
Reason for abandonment of well or producing formation _____

D & A
If a producing well is abandoned, date of last production _____ 19__

Was permission obtained from the Conservation Division or its agents before plugging was commenced? Yes

Name of Conservation Agent who supervised plugging of this well Wm. T. Owen

Producing formation _____ Depth to top _____ Bottom _____ Total Depth of Well 3,798'

Show depth and thickness of all water, oil and gas formations.

OIL, GAS OR WATER RECORDS

CASING RECORD

FORMATION	CONTENT	FROM	TO	SIZE	PUT IN	PULLED OUT
				8 5/8"	200.33'	-0-

Describe in detail the manner in which the well was plugged, indicating where the mud fluid was placed and the method or methods used in introducing it into the hold. If cement or other plugs were used, state the character of same and depth placed, from _____ feet to _____ feet for each plug set.

Plugged hole with mud to 210' w/40 sx cement
mud to 40' w/bridge & 12 sx cement
3 sx cement in rathole
Cement was 60/40 Pozmix, 2% Gel **RECEIVED**

STATE CORPORATION COMMISSION

NOV 22 1978

CONSERVATION DIVISION
Wichita, Kansas

(If additional description is necessary, use BACK of this sheet)

Name of Plugging Contractor Red Tiger Drilling Company & Allied Cementing Company

STATE OF Kansas COUNTY OF Sedgwick, ss. contractor
Gloria Fawcett (employee of ~~xxxxxx~~)


of the above-described well, being first duly sworn on oath, says: That I have knowledge of the facts, statements, and matters herein contained and the log of the above-described well as filed and that the same are true and correct. So help me God.

(Signature) Gloria Fawcett
1720 KSB&T Building, Wichita, Kansas 67202
(Address)

SUBSCRIBED AND SWORN TO before me this 20th day of November, 1978.

Joyce A. Hagermann
Notary Public.

My commission expires _____

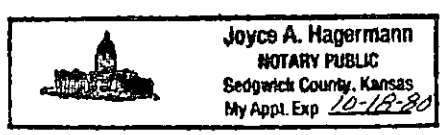

15-095-20775-000

DRILLERS LOG

NO. 4 BROWN

CASING RECORD: 8 5/8" @ 209.73' w/175 sx cement
 COMPANY: Gear Petroleum Company
 CONTRACTOR: Red Tiger Drilling Company
 COMMENCED: November 6, 1978
 COMPLETED: November 14, 1978
 DESCRIPTION: C NW/4 NE/4 SE/4 Sec. 4-T28S-R5W Kingman County, Kansas
 TOTAL DEPTH: 3,798' ELEVATION: 1,432' KB

<u>FORMATION</u>	<u>FROM</u>	<u>TO</u>	<u>REMARKS</u>
Surface Soil, Clay, Sand	0	42	
Red Bed	42	193	
Shale	193	743	
Anhydrous & Shale	743	899	
Lime, Shale & Salt	899	1145	
Lime w/Shale	1145	1510	
Lime	1510	1990	
Lime & Shale	1990	2205	
Lime	2205	2552	
Lime & Shale	2552	3008	
Lime	3008	3515	
Lime & Shale	3515	3660	
Lime	3660	3769	
Chert	3769	3790	
Mississippi Chert	3790	3798	
RTD		3798	


I certify that this is a true and correct copy of the above log to the best of my knowledge.

RED TIGER DRILLING COMPANY

Gloria Fawcett
Gloria Fawcett

Subscribed and sworn to before me this 20th day of November, 1978.

Joyce A. Hagermann
Notary Public

 Joyce A. Hagermann
 NOTARY PUBLIC
 Sedgwick County, Kansas
 My Appt. Exp 12-18-80

RECEIVED
 STATE CORPORATION COMMISSION
 NOV 22 1978
 CONSERVATION DIVISION
 Wichita, Kansas