


WELL PLUGGING RECORD

Give All Information Completely
Make Required Affidavit
Mail or Deliver Report to:
Conservation Division
State Corporation Commission
800 Bitting Building
Wichita, Kansas

NORTH

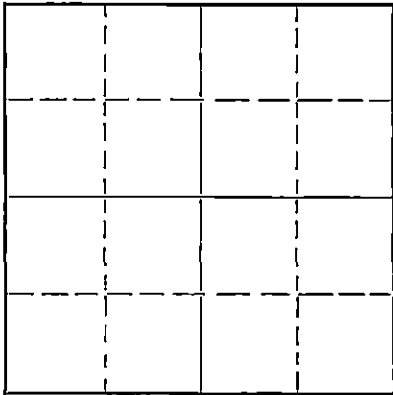

Locate well correctly on above
Section Plat

Kingman County. Sec. 4 Twp. 28S Rge. 5W (E) (W)
Location as "NE/CNW $\frac{1}{4}$ SW $\frac{1}{4}$ " or footage from lines SE, SW, SE
Lease Owner O. A. Sutton Corporation - Ralph J. Weaver
Lease Name Turner Well No. 1
Office Address 603 Petroleum Bldg., Wichita, Ks.
Character of Well (completed as Oil, Gas or Dry Hole) dry hole
Date well completed 2/21 1951
Application for plugging filed February 21, 1951
Application for plugging approved February 21, 1951
Plugging commenced February 21, 1951
Plugging completed February 22, 1951
Reason for abandonment of well or producing formation dry hole

If a producing well is abandoned, date of last production 19...
Was permission obtained from the Conservation Division or its agents before plugging was commenced? yes

Name of Conservation Agent who supervised plugging of this well Ruel Durkee, McPherson, Kansas
Producing formation Depth to top Bottom Total Depth of Well 3861 Feet
Show depth and thickness of all water, oil and gas formations.

OIL, GAS OR WATER RECORDS

CASING RECORD

Formation	Content	From	To	Size	Put In	Pulled Out
				8-5/8"	114'	none

Describe in detail the manner in which the well was plugged, indicating where the mud fluid was placed and the method or methods used in introducing it into the hole. If cement or other plugs were used, state the character of same and depth placed, from top feet to bottom feet for each plug set.

Mud to 114 feet, set plug and dumped 15 sacks of cement; mud to 30 feet, set plug and dumped 5 sacks of cement to complete.

RECEIVED
MAR 15 1951
CONSERVATION DIVISION
Wichita, Kansas

3-15-51

(If additional description is necessary, use BACK of this sheet)
Correspondence regarding this well should be addressed to Beardmore Drilling Company, Inc.
Address 603 Petroleum Bldg., Wichita, Kansas

STATE OF KANSAS, COUNTY OF SEDGWICK, ss.
Heber Beardmore (employee of owner) or (owner or operator) of the above-described well,
being first duly sworn on oath, says: That I have knowledge of the facts, statements, and matters herein contained and the log of the above-described well as filed and that the same are true and correct. So help me God.

(Signature) Heber Beardmore
603 Petroleum Bldg., Wichita, Kansas
(Address)

SUBSCRIBED AND SWORN to before me this 28th day of February, 1951.
Annette A. Kennelley
Notary Public.

commission expires Jan. 19, 1955.

PLUGGING
FILE SEC 41 XRSW
BOOK PAGE 364 OF 13

15-095-01471-0000

Turner No. 1 Well

SE, SW, SE,
Section 4-28S-5W,
Kingman County, Kansas

Drilled For: Sutton Corp.-Weaver et al
Drilled By: Beardmore Drilling Co., Inc.

Casing Record:

8-5/8" 11 1/2' w/100 sks

Drilling Commenced: February 9, 1951.
Drilling Completed: February 21, 1951.

<u>FORMATION</u>	<u>DEPTH</u>
Surface clay	5
Red Rock - Sand	65
Shale - shells	1025
Lime	1375
Shale - shells	2025
Shale - lime	2225
Lime - shale	3025
Lime broken	3100
Lime	3330
Lime - shale	3470
Shale - lime	3535
Lime - shale	3635
Shale - lime	3700
Shale	3786
Mississippi lime	3796
Lime	3861 T.D.

D & A

Elevation 1123 D.F.

Tops:

Lansing 2975 (-1550)
Mississippi Chat 3786 (-2361)

STATE OF KANSAS

SS

COUNTY OF SEDGWICK

I, the undersigned, being duly sworn on oath, state that the above and within statement is a true and correct log and record of the well drilled on the location above-described, to the best of my knowledge and belief.

Alvin Beardmore

Subscribed and sworn to before me this 11th day of March, 1951.

Annette A. Kennally
Notary Public

My Commission Expires:

Jan. 17, 1955.

PLUGGING
FILE SEC 4-28S-5W
BOOK PAGE 64 LINE 13

RECEIVED
JANUARY COMMISSION
MAR 15 1951
CONSERVATION DIVISION
Wichita, Kansas