


WELL PLUGGING RECORD

Give All Information Completely
Make Required Affidavit
Mail or Deliver Report to:
Conservation Division
State Corporation Commission
800 Bitting Building
Wichita, Kansas

NORTH

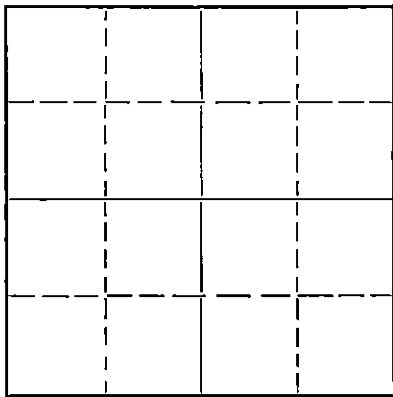

Locate well correctly on above
Section Plat

Kingman County. Sec. 5 Twp. 28 Rge. (E) 5(W)
Location as "NE/CNW $\frac{1}{4}$ SW $\frac{1}{4}$ " or footage from lines SE SE SE
Lease Owner Pabco Drilling, Inc et al
Lease Name Ramsdale Well No. I
Office Address Wichita Kansas
Character of Well (completed as Oil, Gas or Dry Hole) dry hole
Date well completed 7-2-51 19
Application for plugging filed oran 10-31-51 19
Application for plugging approved oral 10-31-51 19
Plugging commenced 11-1-51 19
Plugging completed 11-10-51 19
Reason for abandonment of well or producing formation

If a producing well is abandoned, date of last production 19
Was permission obtained from the Conservation Division or its agents before plugging was commenced? yes

Name of Conservation Agent who supervised plugging of this well Roul Durkee
Producing formation Depth to top Bottom Total Depth of Well 3822 Feet
Show depth and thickness of all water, oil and gas formations.

OIL, GAS OR WATER RECORDS

CASING RECORD

Formation	Content	From	To	Size	Put In	Pulled Out
				8-5/8"	156	none
				5-1/2"	3777	3344

Describe in detail the manner in which the well was plugged, indicating where the mud fluid was placed and the method or methods used in introducing it into the hole. If cement or other plugs were used, state the character of same and depth placed, from feet to feet for each plug set.

From 3790 to 3770 filled with sand. 3770 to 3740 cemented with 6. sx cement. 3740 to cellar cemented with 325. sx mud and 50. sx cement.

11-30-51

(If additional description is necessary, use BACK of this sheet)

Name of Plugging Contractor H & S Pipe Pulling Co
Address Box 192 Ellinwood Kansas

STATE OF Kansas, COUNTY OF Sedgewick, ss.
D. J. Briggs (employee of owner) or (owner) operator of the above-described well,

being first duly sworn on oath, says: That I have knowledge of the facts, statements, and matters herein contained and the log of the above-described well as filed and that the same are true and correct. So help me God. PABCO DRILLING, INC.

(Signature) By D. J. Briggs
Wichita Kansas (Address)

SUBSCRIBED AND SWORN TO before me this 27th day of November, 19 51

Ruth M. Gardner
Notary Public.

My commission expires March 2, 1953

FILE 5. 21. 1950
BOOK PAGE 171

15-095-20198-000

DRILLERS LOG

COMPANY: Pabco Drilling, Inc.
CONTRACTOR: Pabco Drilling, Inc.

LOCATION: SE SE SE
5-28-5W
Kigman Co
Kansas

FARM NAME: No. 1 Ramsdale

COMMENCED: 5-30-51
COMPLETED: 6-9 -51

CASING USED:

8 5/8" 156'
5 1/2" 3777' com w/125 sx
com w/ 50 sx

Sand	50	
Sand, Shale & Shells	156	
Shale & Shells	610	
Salt & Shale	720	
Shale & Shells	805	
Shale & Lime	985	
Lime	1175	
Lime & Shale	1400	
Shale & Shells	1585	ST OK @ 1500
Shale & Lime	1735	
Sand & Shale	1800	
Shale & Shells	1860	
Sandy Shale	1915	
Shale & Shells	1995	
Shale & Lime	2190	ST & SIM OK @ 2400
Lime	2994	ST & SIM OK @ 3050
Lime & Shale	3480	
Lime	3790	ST & SIM OK @ 3600
Total Depth	3790	DST

STATE OF KANSAS }
COUNTY OF SEDGWICK) SS

I, D. J. Briggs, do hereby certify that the above is a true and correct copy of the log on the above captioned well, as shown on the daily drilling reports.

PABCO DRILLING, INC.

D. J. Briggs
D. J. Briggs, President

Subscribed and sworn to before me this 11 day of June 1951.

Rob M. Gardner
Notary Public

My commission expires March 2, 1953.