

CARD MUST BE TYPED

State of Kansas  
**NOTICE OF INTENTION TO DRILL**  
(see rules on reverse side)

CARD MUST BE SIGNED

Starting Date: June 28, 1985  
month day year

API Number 15- 095-21,531-000

OPERATOR: License # 5348

NE SE SE Sec 24 Twp 28 S, Rge 7  East  
 West  
(location)

Name Robert E. Campbell

Address 260 N. Rock Road, Suite 110

City/State/Zip Wichita, KS 67206

Contact Person Robert E. Campbell

Phone (316) 685-6001

990 Ft North from Southeast Corner of Section

330 Ft West from Southeast Corner of Section

(Note: Locate well on Section Plat on reverse side)

CONTRACTOR: License # 5107

Name H-30, Inc.

City/State Wichita, KS

Nearest lease or unit boundary line 330 feet.

County Kingman

Lease Name Messenger Well# 1

Domestic well within 330 feet:  yes  no

Municipal well within one mile:  yes  no

Well Drilled For: Well Class: Type Equipment:

Oil  Swd

Infield

Mud Rotary

Gas  Inj

Pool Ext.

Air Rotary

OWWO  Expl

Wildcat

Cable

Depth to Bottom of fresh water 100 feet

Lowest usable water formation Harper Sandstone

Depth to Bottom of usable water 200 feet

Surface pipe by Alternate: 1  2

Surface pipe to be set 225± feet

Conductor pipe if any required feet

Ground surface elevation 1571 feet MSL

This Authorization Expires 12-27-85

Approved By 6-27-85

If OWWO: old well info as follows:

Operator

Well Name

Comp Date Old Total Depth

Projected Total Depth 2150 feet

Projected Formation at TD Indian Cave

Expected Producing Formations Indian Cave

I certify that we will comply with K.S.A. 55-101, et seq., plus eventually plugging hole to K.C.C. specifications.

Date 6-27-85 Signature of Operator or Agent

Abigail A. White Title

MHC/MONE 6-27-85 Agent

RECEIVED

Must be obtained with the K.C.C. five (5) days prior to commencing well  
This card void if drilling not started within six (6) months of date received by K.C.C.


JUN 27 1985

6-27-85

CONSERVATION DIVISION  
Wichita, Kansas

**Important procedures to follow :**

**A Regular Section of Land  
1 Mile = 5,280 Ft.**

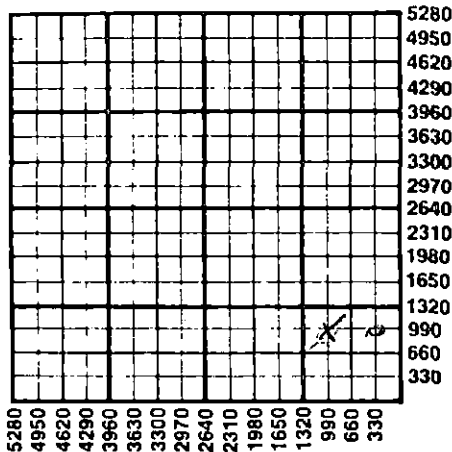

1. Notify District office before setting surface casing.
2. Set surface casing by circulating cement to the top.
3. File completion forms ACO-1 with K.C.C. within 90 days of well completion, following instructions on ACO-1, side 1, and including copies of wireline logs.
4. Notify District office 48 hours prior to old well workover or re-entry.
5. Prior to plugging, prepare a plugging plan, then obtain agreement from the appropriate district office for an approved plugging plan.
6. Submit plugging report (CP-4) to K.C.C. after plugging is completed.
7. Obtain an approved injection docket number before disposing of salt water.
8. Notify K.C.C. within 10 days when injection commences or terminates.
9. If an alternate 2 completion, cement in the production pipe from below any useable water to surface within 120 days of spud date.

**State Corporation Commission of Kansas  
Conservation Division  
200 Colorado Derby Building  
Wichita, Kansas 67202  
(316) 263-3238**