

CARD MUST BE TYPED

State of Kansas
NOTICE OF INTENTION TO DRILL

²⁴⁴ ~~COLLECTOR~~
CARD MUST BE SIGNED

(see rules on reverse side)

Starting Date: May 7 1985
month day year

API Number 15- 095-21,524-0000 ⁵⁻¹⁻⁸⁵

OPERATOR: License # 7811

X C.S. / 2-SE-NE... Sec .24 Twp .28 S, Rge .7. East
(location) West

Name William's Bros. Eng. Co.

Address 6600 South Yale

City/State/Zip Tulsa, Ok. 74136

Contact Person John L. Liston

Phone 316/ 792 - 4356

2970 Ft North from Southeast Corner of Section
X ~~550~~ 760 Ft West from Southeast Corner of Section
(Note: Locate well on Section Plat on reverse side)

CONTRACTOR: License # 5652

Nearest lease or unit boundary line 330 feet.

County Kingman

Name Mustang Drg. & Exl. Inc.

Lease Name Messenger Well# 1

City/State Great Bend, Kansas

Domestic well within 330 feet: yes no

Well Drilled For: Well Class: Type Equipment:

Municipal well within one mile: yes no

Oil Swd Infield Mud Rotary

Depth to Bottom of fresh water 80 feet

Gas Inj Pool Ext. Air Rotary

Lowest usable water formation Nippewalla

OWWO Expl Wildcat Cable

Depth to Bottom of usable water 200 feet

If OWWO: old well info as follows:

Surface pipe by Alternate: 1 2

Operator

Surface pipe to be set 200 feet

Well Name

Conductor pipe if any required feet

Comp Date Old Total Depth

Ground surface elevation 1561 feet MSL

Projected Total Depth 4425 feet

This Authorization Expires 10-25-85

Projected Formation at TD Viola

Approved By 4-25-85


Expected Producing Formations Ind. Cave, Lans, Miss. Viola

I certify that we will comply with K.S.A. 55-101, et seq., plus eventually plugging hole to K.C.C. specifications. ~~XXXX~~ SWSE NE 9900

Date 4-30-85 Signature of Operator or Agent John L. Liston Title Senior Foreman 660 FEL

MAY 1 1985
5-1-85
CONSERVATION DIVISION
Wichita, Kansas

A Regular Section of Land
1 Mile = 5,280 Ft.

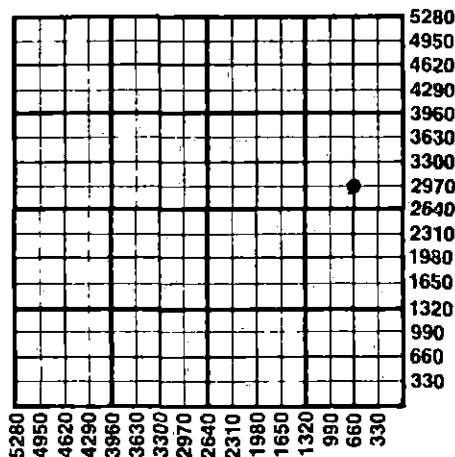

Important procedures to follow:

1. Notify District office before setting surface casing.
2. Set surface casing by circulating cement to the top.
3. File completion forms ACO-1 with K.C.C. within 90 days of well completion, following instructions on ACO-1, side 1, and including copies of wireline logs.
4. Notify District office 48 hours prior to old well workover or re-entry.
5. Prior to plugging, prepare a plugging plan, then obtain agreement from the appropriate district office for an approved plugging plan.
6. Submit plugging report (CP-4) to K.C.C. after plugging is completed.
7. Obtain an approved injection docket number before disposing of salt water.
8. Notify K.C.C. within 10 days when injection commences or terminates.
9. If an alternate 2 completion, cement in the production pipe from below any usable water to surface within 120 days of spud date.

State Corporation Commission of Kansas
Conservation Division
200 Colorado Derby Building
Wichita, Kansas 67202
(316) 263-3238