

CARD MUST BE TYPED

State of Kansas

CARD MUST BE SIGNED

NOTICE OF INTENTION TO DRILL

\*\*CORRECTION\*\*

(see rules on reverse side)

VO, C

Expected Spud Date. March 29, 1988 month day year

API Number 15-095-21,586-0000

OPERATOR: License # 4419
Name BEAR PETROLEUM
Address P. O. Box 243
City/State/Zip Derby, Kansas 67037
Contact Person Dick Schremmer
Phone 316/788-5551

\*\* NW SE NW Sec. 19 Twp. 28 S, Rg. 5 East
\*\* 3630 Ft. from South Line of Section
3630 Ft. from East Line of Section

(Note: Locate well on Section Plat on reverse side)

CONTRACTOR: License # 5929
Name DUKE DRILLING CO., INC.
City/State Great Bend, Kansas 67530

Nearest lease or unit boundary line 330 feet
County Kingman
Lease Name Viney Well # 2

Ground surface elevation feet MSL

Domestic well within 330 feet: yes X no

Municipal well within one mile: yes X no

Well Drilled For: Well Class: Type Equipment:
X Oil Storage X Infield X Mud Rotary
Gas Inj Pool Ext Air Rotary
OWWO Expl Wildcat Cable

Depth to bottom of fresh water 50

Depth to bottom of usable water 180

Surface pipe by Alternate: 1X 2

If OWWO: old well info as follows:

Surface pipe planned to be set 200

Conductor pipe required

Projected Total Depth 4000 feet

Formation

Operator
Well Name
Comp Date Old Total Depth

I certify that well will comply with K.S.A. 55-101, et seq., plus eventually plugging hole to KCC specifications.

Date March 29, 1988 Signature of Operator or Agent Sally R. Myers Title Agent

For KCC Use:

Conductor Pipe Required feet; Minimum Surface Pipe Required 200 feet per Alt. 1 2

This Authorization Expires 9-25-88 Approved By PCH 3-25-88 3-30-88


\*\*WAS: SW NE NW 4290'FSL

Must be filed with the K.C.C. five (5) days prior to commencing well  
This card void if drilling not started within six (6) months of date received by K.C.C.

Important procedures to follow:

1. Notify District office before setting surface casing.
2. Set surface casing by circulating cement to the top.
3. File completion forms ACO-1 with K.C.C. within 120 days of well spud date, following instructions on ACO-1, side 1, and including copies of wireline logs.
4. Notify District office 48 hours prior to old well workover or re-entry.
5. Prior to filing Intent, prepare a proposed plugging plan in case well is D & A, then obtain approval of plan when calling district office prior to setting surface pipe.
6. Submit plugging report (CP-4) to K.C.C. after plugging is completed.
7. Obtain an approved injection docket number before disposing of salt water.
8. Notify K.C.C. within 10 days when injection commences or terminates.

A Regular Section of Land  
1 Mile = 5,280 Ft.

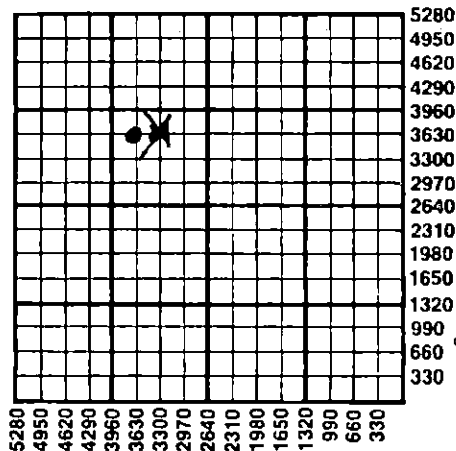

If an alternate 2 completion, cement in the production pipe from below any usable water to surface within 120 days of spud date.

RECEIVED  
MAR 5 0 1988  
STATE CORPORATION COMMISSION  
CONSERVATION DIVISION  
WICHITA, KANSAS  
03-30-88

State Corporation Commission of Kansas  
Conservation Division  
200 Colorado Derby Building  
Wichita, Kansas 67202-1212  
(316) 263-3238