

Must be approved by the K.C.C. five (5) days prior to commencing well

Expected Spud Date 3 25 89 Approx. C. SW SW Sec. 14 Twp. 28 S, R. 10 X East
month day year

OPERATOR: License # 3711
Name: Shepler & Thomas, Inc.
Address: P.O. Box 1162
City/State/Zip: Liberal, KS 67905-1162
Contact Person: R. F. Burke
Phone: (316) 624-0750

CONTRACTOR: License #: Unknown
Name: _____

Well Drilled For: Well Class: Type Equipment:
X Oil X Inj X Infield X Mud Rotary
X Gas X Storage X Pool Ext. X Air Rotary
X OWD X Disposal X Wildcat X Cable
X Seismic; X # of Holes

If OWD, old well information as follows:
Operator: _____
Well Name: _____
Comp. Date: _____ Old Total Depth _____

Directional, Deviated or Horizontal wellbore? yes X no
If yes, total depth location: _____

* 800 feet from South line of Section
* 4760 feet from East line of Section
(Note: Locate well on Section Plat Below)

County: Kingman
Lessee Name: Holcomb Well #: 1-14
Field Name: N/A
Is this a Prorated Field? yes X no
Target Formation(s): Red Cave
* Nearest lease or unit boundary: 520
Ground Surface Elevation: N/A feet MSL
Domestic well within 330 feet: yes X no
Municipal well within one mile: yes X no
Depth to bottom of fresh water: 180
Depth to bottom of usable water: 180
Surface Pipe by Alternate: X 1 X 2
Length of Surface Pipe Planned to be set: 225
Length of Conductor pipe required: N/A
Projected Total Depth: 2700
Formation at Total Depth: Red Cave
Water Source for Drilling Operations: Unknown
... well ... farm pond ... other

DWR Permit #: _____
Will Cores Be Taken?: yes X no
If yes, proposed zone: _____

* WAS: 660' FSL, 4620' FEL, 660' FLL

AFFIDAVIT


The undersigned hereby affirms that the drilling, completion and eventual plugging of this well will comply with K.S.A. 55-301, et. seq.

It is agreed that the following minimum requirements will be met:

1. The appropriate district office shall be notified before setting surface pipe;
2. The minimum amount of surface pipe as specified above shall be set by circulating cement to the top; in all cases surface pipe shall be set through all unconsolidated materials plus a minimum of 20 feet into the underlying formation;
3. If the well is dry, a plugging proposal shall be submitted to the district office. An agreement between the operator and the district office on plug length and placement is necessary prior to plugging;
4. The appropriate district office will be notified before well is either plugged or production casing is cemented in;
5. If an Alternate II completion, production pipe shall be cemented from below any usable water to surface within 120 days of spud date. In all cases, notify district office prior to any cementing.

I hereby certify that the statements made herein are true and to the best of my knowledge and belief.

Date: 3-20-89 Signature of Operator or Agent: R. F. BURKE Title: Agent

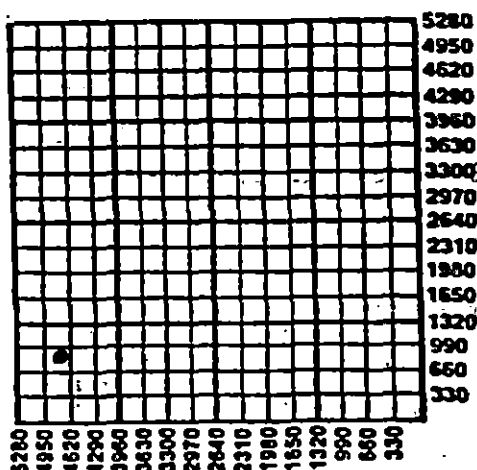

RECEIVED
STATE CORPORATION COMMISSION

3-23-89
MAR 23 1989

CONSERVATION DIVISION
Wichita, Kansas

FOR KCC-USE:

API # 15- 095-21,608-0000
Conductor pipe required NONE feet
Minimum surface pipe required 200 feet per Alt. OK
Approved by: LKM 3-15-89
EFFECTIVE DATE: 3-20-89
This authorization expires: 9-15-89
(This authorization void if drilling not started within 6 months of effective date.)
Spud date: _____ Agent: _____

REMEMBER TO:

- File Drill Pit Application (form CDP-1) with Intent to Drill;
- File Completion Form ACD-1 within 120 days of spud date;
- File acreage attribution plat according to field proration orders;
- Notify appropriate district office 48 hours prior to workover or re-entry;
- Submit plugging report (CP-4) after plugging is completed;
- Obtain written approval before disposing or injecting salt water.